

CARD MUST BE TYPED

State of Kansas

CARD MUST BE SIGNED

NOTICE OF INTENTION TO DRILL

(see rules on reverse side)

Expected Spud Date. MAY 20, 1987
month day year

API Number 15— 059-24232-00-00 ✓ 6

OPERATOR: License # 9873

SW SW NW Sec. 10 Twp. 16 S, Rg. 20 X East
_____ West

Name PAINTER OIL CO., INC.

Address 5865 FAIRWOOD LANE

City/State/Zip MEMPHIS, TENN. 38119

Contact Person JOE SMITH

Phone 901-685-7121

2970 Ft. from South Line of Section

4950 Ft. from East Line of Section

(Note: Locate well on Section Plat on reverse side)

Nearest lease or unit boundary line 330 feet

County FRANKLIN

CONTRACTOR: License # 6807

Lease Name TOM SEYLER Well # 1

Name oil driller and developers, inc.

City/State 901 GARFIELD, TOPEKA, KS 66606

Ground surface elevation _____ feet MSL

Well Drilled For: Well Class: Type Equipment:

Domestic well within 330 feet: _____ yes X no

X Oil _____ Storage _____ Infield X Mud Rotary

Municipal well within one mile: _____ yes X no

X Gas _____ Inj _____ Pool Ext. _____ Air Rotary

Depth to bottom of fresh water. _____

_____ OWWO _____ Expl X Wildcat _____ Cable

Depth to bottom of usable water 200

If OWWO: old well info as follows:

Surface pipe by Alternate: _____ 1 _____ 2 X

Operator _____

Surface pipe planned to be set 40

Well Name _____

Conductor pipe required _____

Comp Date _____ Old Total Depth _____

Projected Total Depth 800 feet

I certify that well will comply with K.S.A. 55-101, et seq., plus eventually plugging hole to KCC specifications.

Date 5-19-87 Signature of Operator or Agent Joe Smith Title AS AGENT

Formation SQUIRREL

For KCC Use:

Conductor Pipe Required _____ feet; Minimum Surface Pipe Required 20 feet per Alt. 2


This Authorization Expires 11-19-87 Approved By _____ 5-19-87

Must be filed with the K.C.C. five (5) days prior to commencing well
 This card void if drilling not started within six (6) months of date received by K.C.C.

Important procedures to follow:

1. Notify District office before setting surface casing.
2. Set surface casing by circulating cement to the top.
3. File completion forms ACO-1 with K.C.C. within 120 days of well spud date, following instructions on ACO-1, side 1, and including copies of wireline logs.
4. Notify District office 48 hours prior to old well workover or re-entry.
5. Prior to filing Intent, prepare a proposed plugging plan in case well is D & A, then obtain approval of plan when calling district office prior to setting surface pipe.
6. Submit plugging report (CP-4) to K.C.C. after plugging is completed.
7. Obtain an approved injection docket number before disposing of salt water.
8. Notify K.C.C. within 10 days when injection commences or terminates.

A Regular Section of Land
 1 Mile = 5,280 Ft.

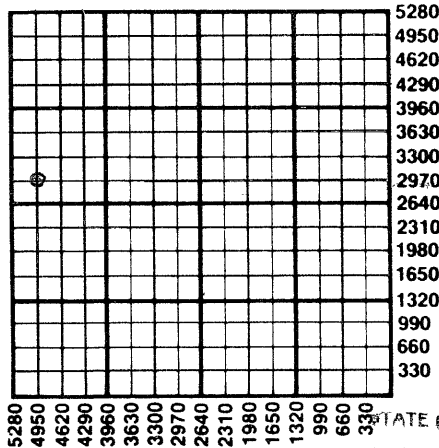

RECEIVED

STATE CORPORATION COMMISSION

MAY 18 1987

CONSERVATION DIVISION
 Wichita, Kansas

5-18-87

alternate 2 completion, cement in the production pipe from below any usable water to surface within 120 days of spud date.

State Corporation Commission of Kansas
 Conservation Division
 200 Colorado Derby Building
 Wichita, Kansas 67202-1212
 (316) 263-3238