


WELL PLUGGING RECORD

Give All Information Completely
Make Required Affidavit
Mail or Deliver Report to:
Conservation Division
State Corporation Commission
211 No. Broadway
Wichita, Kansas

NORTH

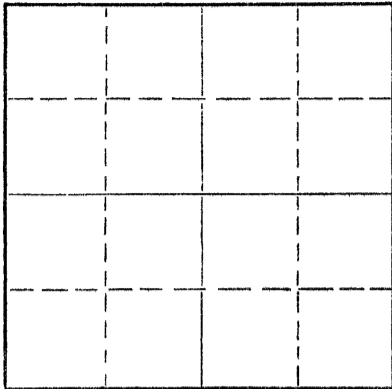

Locate well correctly on above
Section Plat

Rooks County. Sec. 1 Twp. 8S Rge. (Ex 18(W))
Location as "NE/CNW/SW" or footage from lines SE SE NE
Lease Owner Clinton Oil Co. & Jones-Gebert Oil, Inc.
Lease Name Williams Well No. 1
Office Address 205 Central Bldg., Wichita, Kansas
Character of Well (completed as Oil, Gas or Dry Hole) Dry Hole
Date well completed Nov. 6 19 63
Application for plugging filed Nov. 6 19 63
Application for plugging approved Nov. 6 19 63
Plugging commenced Nov. 6 19 63
Plugging completed Nov. 6 19 63
Reason for abandonment of well or producing formation Dry Hole

If a producing well is abandoned, date of last production 19
Was permission obtained from the Conservation Division or its agents before plugging was commenced? Yes

Name of Conservation Agent who supervised plugging of this well Eldon Petty, Hays, Kansas
Producing formation Depth to top Bottom Total Depth of Well 3440 Feet
Show depth and thickness of all water, oil and gas formations.

OIL, GAS OR WATER RECORDS

CASING RECORD

FORMATION	CONTENT	FROM	TO	SIZE	PUT IN	PULLED OUT
				8-5/8"	160'	

Describe in detail the manner in which the well was plugged, indicating where the mud fluid was placed and the method or methods used in introducing it into the hole. If cement or other plugs were used, state the character of same and depth placed, from feet to feet for each plug set.

Plug @540' w/20 sx., Plug @180 w/20 sx.,
Plug @3 w/10 sx.

RECEIVED
STATE CORPORATION COMMISSION

NOV 13 1963

11-13-1963

CONSERVATION DIVISION
Wichita, Kansas

(If additional description is necessary, use BACK of this sheet)

Name of Plugging Contractor Jones-Gebert Oil, Inc.
Address 205 Central Bldg., Wichita, Kansas

STATE OF Kansas, COUNTY OF Sedgwick, ss.
George R. Jones

(employee or owner or (owner or operator) of the above-described well, being first duly sworn on oath, says: That I have knowledge of the facts, statements, and matters herein contained and the log of the above-described well as filed and that the same are true and correct. So help me God.

(Signature) [Signature]
205 Central Bldg., Wichita, Kansas
(Address)

SUBSCRIBED AND SWORN TO before me this 12th day of November, 19 63

My commission expires February 1, 1964

[Signature]
Barbara J. Layton
Notary Public.

15-163-01086-00-00

DRILLERS' LOG

Company: Clinton Oil Co. & Jones-Gebert Oil, Inc.
 Contractor: Jones-Gebert Oil, Inc.
 Farm: #1 Williams, SE SE NE
 Sec. 1-8S-18W
 Rooks Co., Kansas
 Commenced: 10/29/63
 Completed: 11/6/63
 Casing: 8-5/8" @160' w/135 sx.

0	-	160	Surface
160	-	335	Shale
335	-	875	Shale, red bed
875	-	997	Sand
997	-	1357	Red bed & shale
1357	-	1398	Anhydrite
1398	-	1715	Shale & sand
1715	-	1850	Shale & shells
1850	-	1975	Lime & shale
1975	-	2110	Shale & lime
2110	-	2165	Lime & shale
2165	-	2325	Lime & shale
2325	-	2400	Lime & shale
2400	-	2570	Lime & shale
2570	-	2765	Lime & shale
2765	-	2915	Lime & shale
2915	-	2975	Lime & shale
2975	-	3080	Lime & shale
3080	-	3220	Lime & shale
3220	-	3275	Lime & shale
3275	-	3320	Lime & shale
3320	-	3375	Lime & shale
3375	-	3410	Lime
3410	-	3440	Lime
		3440	Rotary Total Depth

RECEIVED
 STATE CORPORATION COMMISSION
 NOV 13 1963
 11-13-1963
 CONSERVATION DIVISION
 Wichita, Kansas

I, George R. Jones, do hereby certify that the above and foregoing is a true and correct copy of the log of the #1 Williams, SE SE NE, Sec. 1-8S-18W, Rooks Co., Kansas, as reflected by the files of Jones-Gebert Oil, Inc.

George R. Jones

 GEORGE R. JONES

State of Kansas)
) ss:
 County of Sedgwick)

Subscribed and sworn to before me, a Notary Public, in and for Sedgwick County, Kansas, this 12th day of November, 1963.

My Commission Expires:
 February 1, 1964

Barbara J. Layton

 Barbara J. Layton, Notary Public