


15-163-00 536-00-00

WELL PLUGGING RECORD

Give All Information Completely
Make Required Affidavit
Mail or Deliver Report to:
Conservation Division
State Corporation Commission
800 Bitting Building
Wichita, Kansas

NORTH

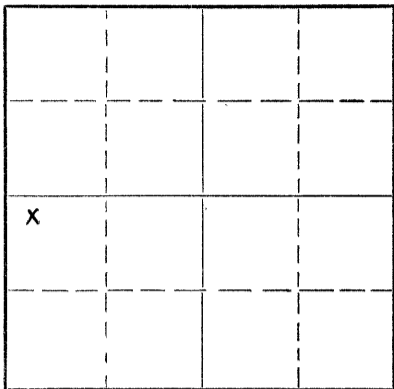

Locate well correctly on above
Section Plat

Hooks County. Sec. 6 Twp. B Rge. 18 (E) W (W)
Location as "NE/CNW/SW" or footage from lines NW1/4 NW1/4 SW1/4
Lease Owner E. H. Riggs & Schafer Drilling Company
Lease Name Collins Well No. 1
Office Address 701 Union National Bank Bldg. Wichita, Kansas
Character of Well (completed as Oil, Gas or Dry Hole) Dry Hole
Date well completed September 18 1953
Application for plugging filed September 18 1953
Application for plugging approved September 18 1953
Plugging commenced September 18 1953
Plugging completed September 18 1953
Reason for abandonment of well or producing formation Dry Hole

If a producing well is abandoned, date of last production _____ 19____
Was permission obtained from the Conservation Division or its agents before plugging was commenced? Yes

Name of Conservation Agent who supervised plugging of this well Eldon Petty
Producing formation None Depth to top _____ Bottom _____ Total Depth of Well 3520 Feet
Show depth and thickness of all water, oil and gas formations.

OIL, GAS OR WATER RECORDS

CASING RECORD

FORMATION	CONTENT	FROM	TO	SIZE	PUT IN	PULLED OUT
				8 5/8"	156	None

Describe in detail the manner in which the well was plugged, indicating where the mud fluid was placed and the method or methods used in introducing it into the hole. If cement or other plugs were used, state the character of same and depth placed, from _____ feet to _____ feet for each plug set.

Well was circulated with heavy mud and plug was set at 150 feet, 15 sacks of cement were then hand mixed and put through the drill pipe on top of the plug. Second plug was set at 40 feet and 10 sacks of cement were then hand mixed and put through the drill pipe on top of the plug.

10-06-1953

(If additional description is necessary, use BACK of this sheet)
Name of Plugging Contractor Schafer Drilling Company
Address Peoples Bank Building, Pratt, Kansas

STATE OF KANSAS COUNTY OF PRATT ss. _____
James E. Selby (employee of owner) or owner or operator of the above-described well, being first duly sworn on oath, says: That I have knowledge of the facts, statements, and matters herein contained and the log of the above-described well as filed and that the same are true and correct. So help me God.

(Signature) James E. Selby
Peoples Bank Bldg. Pratt, Kansas
(Address)

SUBSCRIBED AND SWORN to before me this 22 day of September, 1953
Hilda Coulter
Notary Public.

My commission expires February 25, 1956

PLUGGING
FILE SEC 6 T 8 R 18.24
BOOK PAGE 130 OF 37

STATE OF KANSAS
STATE CORPORATION COMMISSION

Give All Information Completely
Make Required Affidavit
Mail or Deliver Report to:
Conservation Division
State Corporation Commission
800 Bitting Building
Wichita, Kansas

15-163-00 536-00-00

WELL PLUGGING RECORD

NORTH

X			

Locate well correctly on above
Section Plat

Rooks County, Sec. 6 Twp. 8 Rge. 18 (E) W (W)
Location as "NE/CNW/SW" or footage from lines NW/4 NW/4 SW/4
Lease Owner E. H. Riggs & Schafer Drilling Company
Lease Name Collins Well No. 1
Office Address 701 Union National Bank Bldg. Wichita, Kansas
Character of Well (completed as Oil, Gas or Dry Hole) Dry Hole
Date well completed September 18 19 53
Application for plugging filed September 18 19 53
Application for plugging approved September 18 19 53
Plugging commenced September 18 19 53
Plugging completed September 18 19 53
Reason for abandonment of well or producing formation Dry Hole

If a producing well is abandoned, date of last production 19
Was permission obtained from the Conservation Division or its agents before plugging was commenced? Yes

Name of Conservation Agent who supervised plugging of this well Eldon Petty
Producing formation None Depth to top Bottom Total Depth of Well 3520 Feet
Show depth and thickness of all water, oil and gas formations.

OIL, GAS OR WATER RECORDS

CASING RECORD

FORMATION	CONTENT	FROM	TO	SIZE	PUT IN	PULLED OUT
				8 5/8"	156	None

Describe in detail the manner in which the well was plugged, indicating where the mud fluid was placed and the method or methods used in introducing it into the hole. If cement or other plugs were used, state the character of same and depth placed, from feet to feet for each plug set.

Well was circulated with heavy mud and plug was set at 150 feet, 15 sacks of cement were then hand mixed and put through the drill pipe on top of the plug. Second plug was set at 40 feet and 10 sacks of cement were then hand mixed and put through the drill pipe on top of the plug.

09-23-1953

(If additional description is necessary, use BACK of this sheet)

Name of Plugging Contractor Schafer Drilling Company
Address Peoples Bank Building, Pratt, Kansas


STATE OF KANSAS COUNTY OF PRATT, ss.
James E. Selby (employee of owner) of the above-described well, being first duly sworn on oath, says: That I have knowledge of the facts, statements, and matters herein contained and the log of the above-described well as filed and that the same are true and correct. So help me God.

(Signature) James E. Selby
Peoples Bank Bldg., Pratt, Kansas
(Address)

SUBSCRIBED AND SWORN TO before me this 22 day of September, 19 53

My commission expires February 25, 1956
Hilda Coulter Notary Public.

24-2675-S 2-52-20M

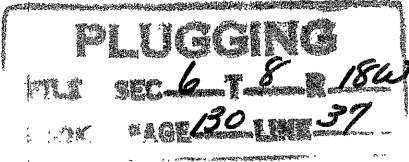

15-163-00536-00-00

DRILLERS' LOG
COLLINS #1

0-126	Sand & Shale
126-625	Shale
625-1260	Sand & Shale
1260-1375	Shale & Shells
1375-1410	Anhydrite
1410-1840	Shale & Shells
1840-1945	Shale & Lime
1945-2210	Shale & Shells
2210-2385	Shale & Lime
2385-2520	Shale & Shells
2520-2790	Shale & Lime
2790-2849	Lime
2849-3065	Shale & Lime
3065-3295	Lime
3295-3340	Shale & Lime
3340-3390	Lime
3390-3425	Shale & Lime
3425-3470	Shale, Lime & Chert
3470-3520	Lime
3520	TOTAL DEPTH

9/23/1953

