


STATE OF KANSAS
STATE CORPORATION COMMISSION

Give All Information Completely
Make Required Affidavit
Mail or Deliver Report to:
Conservation Division
State Corporation Commission
800 Biting Building
Wichita, Kansas

15-163-00537-00-00
WELL PLUGGING RECORD

NORTH

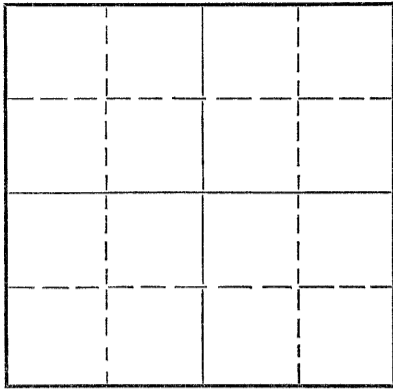

Locate well correctly on above
Section Plat

Rooks County. Sec. 4 Twp. 8 Rge. 18 (E) W (W)
Location as "NE/CNW/SW" or footage from lines NW NW NW
Lease Owner Trans Era Petroleum, Inc.
Lease Name Swaney Well No. 1
Office Address Russell, Kansas
Character of Well (completed as Oil, Gas or Dry Hole) Dry Hole
Date well completed 10/7/53 19
Application for plugging filed 10/5/53 19
Application for plugging approved 10/5/53 19
Plugging commenced 10/6/53 19
Plugging completed 10/6/53 19
Reason for abandonment of well or producing formation Dry Hole

If a producing well is abandoned, date of last production _____ 19
Was permission obtained from the Conservation Division or its agents before plugging was commenced? Yes

Name of Conservation Agent who supervised plugging of this well Eldon Petty
Producing formation _____ Depth to top _____ Bottom _____ Total Depth of Well 3468 Feet
Show depth and thickness of all water, oil and gas formations.

OIL, GAS OR WATER RECORDS

CASING RECORD

FORMATION	CONTENT	FROM	TO	SIZE	PUT IN	PULLED OUT
				8 5/8"	202	None

Describe in detail the manner in which the well was plugged, indicating where the mud fluid was placed and the method or methods used in introducing it into the hole. If cement or other plugs were used, state the character of same and depth placed, from _____ feet to _____ feet for each plug set.

PLUGGING RECORD

Finished laying down drill pipe, plugged hole. Set bottom plug at 180'. Mixed and ran 10 sacks of cement through drill pipe. Set top plug at 40' with 10 sacks of cement.

(If additional description is necessary, use BACK of this sheet)

Name of Plugging Contractor _____
Address _____

STATE OF KANSAS, COUNTY OF RUSSELL, ss.
H. R. Michaelis (employee of owner) or (owner or operator) of the above-described well, being first duly sworn on oath, says: That I have knowledge of the facts, statements, and matters herein contained and the log of the above-described well as filed and that the same are true and correct. So help me God.


(Signature) H. R. Michaelis
Russell, Kansas
(Address)

SUBSCRIBED AND SWORN TO before me this 9th day of October, 1953

My commission expires 1-30-57.

Margie Cooper
Notary Public.

24-7368-S 3-53-20M

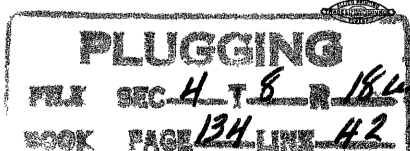

10-13-1953
OCT 13 1953

Trans Era Petroleum, Inc.
Swaney #1

15-143-00537-00-00

NW NW NW 4-8-18
Rooks County, Kansas

Total Depth: 3468'
Comm. 9/28/53
Comp. 10/7/53

Casing

Cement

8 5/8" Set @ 202'

140 sacks of Cement

Formation

Depth

Surface Hole	200
Shale	980
Sand	1040
Shale-shells	1190
Red bed-shale	1270
Sand	1390
Sand-shale	1605
Anhydrite	1640
Shale-shells	1885
Shale-lime	3090
Lime-shale-chert	3150
Lime	3330
Lime-shale	3442
Lime	3468'

STATE OF KANSAS)
) ss
RUSSELL COUNTY)

I hereby certify that the above information is true and correct to the best of my knowledge.

Law Butz

Subscribed and sworn to before me this 9th day of October, 1953.

Margie Cooper
Notary Public

My commission expires: 1-30-57.

RECORDED
OCT 10 1953
DIVISION

PLUGGING

10-13-1953