


STATE OF KANSAS
STATE CORPORATION COMMISSION

Give All Information Completely
Make Required Affidavit
Mail or Deliver Report to:
Conservation Division
State Corporation Commission
1 No. Broadway
Wichita, Kansas

15-163-01053-00-00

WELL PLUGGING RECORD

NORTH

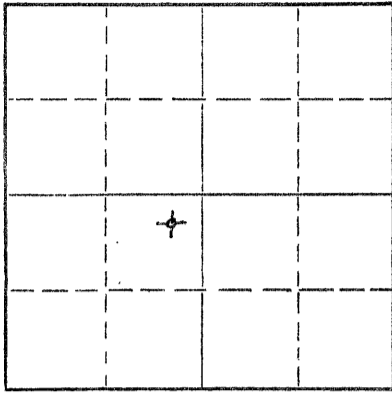

Locate well correctly on above
Section Plat

Rooks _____ County. Sec. 8 Twp. 8S Rge. (E) 18 (W)
Location as "NE/CNW/SW" or footage from lines NE NE SW
Lease Owner Graybol Oil Corporation
Lease Name Milner Well No. 1
Office Address 2200 N. B. T. Bldg., Tulsa, Oklahoma
Character of Well (completed as Oil, Gas or Dry Hole) Dry Hole
Date well completed July 15 1962
Application for plugging filed July 16 1962
Application for plugging approved July 18 1962
Plugging commenced July 15 1962
Plugging completed July 15 1962
Reason for abandonment of well or producing formation Dry Hole

If a producing well is abandoned, date of last production _____ 19____
Was permission obtained from the Conservation Division or its agents before plugging was commenced? Yes

Name of Conservation Agent who supervised plugging of this well Eldon Petty
Producing formation None Depth to top _____ Bottom _____ Total Depth of Well 3500 Feet
Show depth and thickness of all water, oil and gas formations.

OIL, GAS OR WATER RECORDS

CASING RECORD

| FORMATION | CONTENT | FROM | TO | SIZE | PUT IN | PULLED OUT |
|-----------|------------|------|------|--------|--------|------------|
| Lansing | Salt water | 3158 | 3383 | 8 5/8" | 190' | None |
| Arbuckle | Salt water | 3444 | 3500 | | | |
| | | | | | | |
| | | | | | | |
| | | | | | | |
| | | | | | | |

Describe in detail the manner in which the well was plugged, indicating where the mud fluid was placed and the method or methods used in introducing it into the hole. If cement or other plugs were used, state the character of same and depth placed, from _____ feet to _____ feet for each plug set.
Filled hole with heavy mud-laden fluid. Pumped 20 sacks of cement @ 550'. Pumped 20 sacks of cement @ 180' and 10 sacks of cement in top of surface casing.

RECEIVED
STATE CORPORATION COMMISSION
JUL 24 1962
09-24-1962
CONSERVATION DIVISION
Wichita, Kansas

(If additional description is necessary, use BACK of this sheet)
Name of Plugging Contractor Graybol Oil Corporation
Address 2200 N. B. T. Bldg., Tulsa, Oklahoma

STATE OF OKLAHOMA, COUNTY OF Tulsa, ss.
Lyman C. Dennis (employee of owner) or (owner or operator) of the above-described well, being first duly sworn on oath, says: That I have knowledge of the facts, statements, and matters herein contained and the log of the above-described well as filed and that the same are true and correct. So help me God.

(Signature) Lyman C. Dennis
Tulsa, Oklahoma
(Address)

SUBSCRIBED AND SWORN TO before me this 19th day of July, 1962

My commission expires October 8, 1962
Jaw Lawrence Notary Public.



GRAYBOL OIL CORPORATION

Rooks County, Kansas

No. 1 Milner NE NE SW

Section 8-8S-18W

Contractor: Company Tools

Elev: G.L. 1981', D.F. 1987'
K.B. 1987'

Commenced: July 5, 1962

Completed: July 15, 1962

Production: D & A

15-163-61053-00-00

CASING RECORD

190' 8 5/8" cemented with 135 sacks

| | |
|-----------|--------------------|
| 0-190 | Surface |
| 190-880 | Shale and Shells |
| 880-1200 | Sand and shale |
| 1200-1355 | Shale and red beds |
| 1355-1380 | Shale |
| 1380-1420 | Anhydrite |
| 1420-1540 | Shale and shells |
| 1540-2050 | Shale and lime |
| 2050-2190 | Shale and shells |
| 2190-2210 | Shale and lime |
| 2210-2220 | Lime |
| 2220-3000 | Lime and shale |
| 3000-3075 | Shale and sand |
| 3075-3097 | Lime |
| 3097-3175 | Lime and shale |
| 3175-3400 | Lime |
| 3400-3433 | Shale and lime |
| 3433-3456 | Lime and chert |
| 3456-3500 | Lime. Arbuckle |

RECEIVED
STATE CORPORATION COMMISSION

JUL 24 1962

CONSERVATION DIVISION
Wichita, Kansas

7/24/1962

I hereby certify that the above is a true and correct log of the above captioned well as taken from the daily drilling reports.

GRAYBOL OIL CORPORATION

By: Edward Haddad
Edward Haddad, Geologist

Subscribed and sworn to this 19th day of July 1962.

My commission expires: October 8, 1962

Paul Lawrence
NOTARY PUBLIC