

STATE OF KANSAS
STATE CORPORATION COMMISSION


WELL PLUGGING RECORD

Give All Information Completely
Make Required Affidavit
Mail or Deliver Report to:
Conservation Division
State Corporation Commission
800 Bitting Building
Wichita, Kansas

OR
FORMATION PLUGGING RECORD

Strike out upper line
when reporting plug-
ging off formations.

NORTH

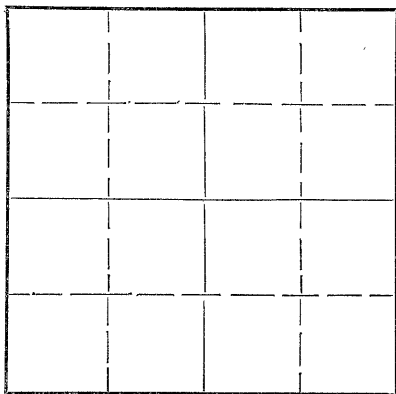

Locate well correctly on above
Section Plat

Rocks..... County. Sec. 8 Twp. 8S Rge. (E) 18 (W)
Location as "NE $\frac{1}{4}$ NW $\frac{1}{4}$ SW $\frac{1}{4}$ " or footage from lines. NW NW NW
Lease Owner Hinkle Oil Company, Apex, et al.
Lease Name Vaverka Well No. 1
Office Address 914 Union National Bank Bldg., Wichita, Kansas.
Character of Well (completed as Oil, Gas or Dry Hole) Dry Hole
Date well completed. 4-29-49 19.
Application for plugging filed. 4-29-49 19.
Application for plugging approved. 4-29-49 19.
Plugging commenced. 4-30-49 19.
Plugging completed. 4-30-49 19.
Reason for abandonment of well or producing formation.....

If a producing well is abandoned, date of last production..... 19.
Was permission obtained from the Conservation Division or its agents before plugging was com-
menced? Yes

Name of Conservation Agent who supervised plugging of this well.....
Producing formation..... Depth to top..... Bottom..... Total Depth of Well..... Feet
Show depth and thickness of all water, oil and gas formations.

OIL, GAS OR WATER RECORDS

CASING RECORD

Formation	Content	From	To	Size	Put In	Pulled Out
				8 5/8"	113'	18 5/8 none

Describe in detail the manner in which the well was plugged, indicating where the mud fluid was placed and the method or methods used in introducing it into the hole. If cement or other plugs were used, state the character of same and depth placed, from.....feet to
.....feet for each plug set.

Mud to 110'
Set wood plug at 110'
run 15 sack cement on plug
filled with mud to 35'
Set wood plug at 35'
Filled with 10 sack cement.

RECEIVED
Conservation Div
05-05-1949
MAY 5 - 1949
STATE CORPORATION
COMMISSION

(If additional description is necessary, use BACK of this sheet)

Correspondence regarding this well should be addressed to Hinkle Oil Company
Address 914 Union National Bank Bldg., Wichita, Kansas.

STATE OF Kansas, COUNTY OF Sedgwick, ss.
J. B. Hinkle (employee of owner) or (owner or operator) of the above-described well,
being first duly sworn on oath, says: That I have knowledge of the facts, statements, and matters herein contained and the log of the above-described well as filed and that the same are true and correct. So help me God.

(Signature) J. B. Hinkle
(Address)

SUBSCRIBED AND SWORN to before me this 4th day of May, 19 49

My commission expires Jan. 17, 1950

22-2625 2-48-151

PLUGGING
8 5/8" 180'
94 JUN 30

Notary Public.

15-163-00211-00-00

Casing record
8 5/8" 113'

Yaverka No. 1. NW NW NW 3-32-18W. Rooks Co. Kansas.
Company, Minkle, Apex, et al.
Contractor. J. B. Minkle.
Commenced 4-18-49 Completed 4-29-49
Elevation 1943

0	5	soil
5	37	lime
37	42	sand and gravel
42	108	blue shale
108	665	shale
665	790	red bed
790	880	sandy shale
880	1330	shale and shells
1330	1395	sandy lime
1395	1480	shale and shells
1480	1550	Anhydrite
1550	1570	broken lime
1570	2200	lime and shale
2200	3389	lime
3389	3413	lime and shale
3413	3418	conglomerate
3418	3443	lime

Top of	Anhydrite	1480
	Lens. K.C.	3116
	Arbuckle	3418

State of Kansas)
County of Sedgwick)

RECEIVED

I hereby certify that the above is a true and correct log as compiled from the daily drilling reports kept on said well.

And further affiant saith not.
STATE CORPORATION COMMISSION
KANSAS

MAY 5 - 1949 5/5/1949

J. B. Minkle

Subscribed and sworn to before me this 4th day of May, 1949.

Murphy A. Lipton
NR

My commission expires 1-17-50

