


Give All Information Completely
Make Required Affidavit
Mail or Deliver Report to:
Conservation Division
State Corporation Commission
211 No. Broadway
Wichita, Kansas

19,149
15-163-~~01024~~-00-00

WELL PLUGGING RECORD

NORTH

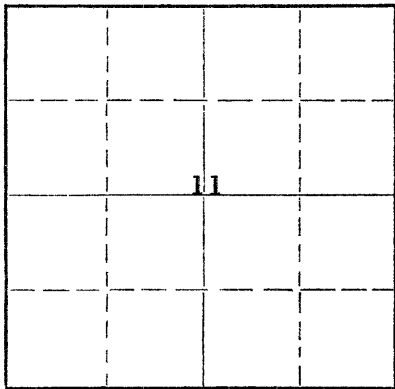

Locate well correctly on above
Section Plat

Rooks County. Sec. 11 Twp. 8S Rge. (E) 18 (W)
Location as "NE/CNW/SW" or footage from lines N W NW NE
Lease Owner Murfin Drilling Co.
Lease Name Gonyac Well No. 1
Office Address 617 Union Center, Wichita, Kansas
Character of Well (completed as Oil, Gas or Dry Hole) Dry Hole
Date well completed 5-1 19 57
Application for plugging filed 5-1 19 57
Application for plugging approved 5-1 19 57
Plugging commenced 5-1 19 57
Plugging completed 5-1 19 57
Reason for abandonment of well or producing formation Dry

If a producing well is abandoned, date of last production _____ 19____
Was permission obtained from the Conservation Division or its agents before plugging was commenced? yes

Name of Conservation Agent who supervised plugging of this well Mr. Eldon Petty
Producing formation _____ Depth to top _____ Bottom _____ Total Depth of Well 3510 Feet
Show depth and thickness of all water, oil and gas formations.

OIL, GAS OR WATER RECORDS

CASING RECORD

FORMATION	CONTENT	FROM	TO	SIZE	PUT IN	PULLED OUT
				8 5/8	164	none

Describe in detail the manner in which the well was plugged, indicating where the mud fluid was placed and the method or methods used in introducing it into the hole. If cement or other plugs were used, state the character of same and depth placed, from _____ feet to _____ feet for each plug set.

Back in hole and layed down 4 1/2" drill pipe and plug hole. Set first plug at 700', mixed 25 sacks of cement through drill pipe and fill hole to 40'. Set plug # 2 and mixed 10 sacks of cement.

(If additional description is necessary, use BACK of this sheet)

Name of Plugging Contractor Murfin Drilling Company
Address 617 Union Center, Wichita, Kansas

STATE OF Kansas, COUNTY OF Sedgwick, ss.
W. R. Murfin (employee of owner) or (owner or operator) of the above-described well, being first duly sworn on oath, says: That I have knowledge of the facts, statements, and matters herein contained and the log of the above-described well as filed and that the same are true and correct. So help me God.

(Signature) WR Murfin

(Address)

SUBSCRIBED AND SWORN TO before me this 13th day of June, 1957

My commission expires November 14, 1957

Constance Miller
Constance Miller
Notary Public.

RECEIVED
STATE CORPORATION COMMISSION
06-18-1957
JUN 18 1957
CONSERVATION DIVISION
Wichita, Kansas

PLUGGING
FILE SEC 11 8 18W
BOOK PAGE 11 LINE 15

WELL LOG

15-143-~~01026~~-00-00

COMPANY Murfin Drilling Co.

19,149

SEC. 11 T. 8 R. 18W

FARM Conyac

NO. 1

LOC. NW NW NE

TOTAL DEPTH 3510

COMM. 4/22/57

COMP. 5/1/57

COUNTY Rooks KANSAS

SHOT OR TREATED

CONTRACTOR Murfin Drilling Co.

ISSUED

CASING

20	10
15	8 5/8 @ 164' w/ 135 sx.
12	6
13	5

ELEVATION 1965 DF

PRODUCTION D & A

FIGURES INDICATE BOTTOM OF FORMATIONS

TOPS:

144	Shale - Shells	Topeka	2906
164	Cement	Heebner	3118
880	Shells - Shale	Toronto	3144
985	Sand - Shale	Kansas City	3162
1345	Shale - Shells	Base Kansas City	3389
1375	Anhy.	Conglomerate	3445
1900	Shells - Shale	Arbuckle	3478
2105	Lime - Shale		
2310	Lime		
2440	Lime - Shale		
2790	Shale - Lime		
2820	Shale		
3165	Lime - Shale		
3445	Lime		
3481	Cong.		
3510	RTD		

PLUGGING
 FILE SEC. 11 T. 8 R. 18W
 BOOK PAGE 11 LN. 15

RECEIVED
 STATE CORPORATION COMMISSION

JUN 19 1957

CONSERVATION DIVISION
 Wichita, Kansas

State of Kansas)
 County of Sedgwick) ss:

I, W. R. Murfin of the Murfin Drilling Company

upon oath state that the above and foregoing is a true and correct copy of the log of the Conyac # 1 well.

W R Murfin

Subscribed and sworn to before me this 13th day of June 19 57

My Commission Expires: November 14, 1960

Constance Miller
 NOTARY PUBLIC
 Constance Miller