


WELL PLUGGING RECORD

Give All Information Completely  
Make Required Affidavit  
Mail or Deliver Report to:  
Conservation Division  
State Corporation Commission  
211 No. Broadway  
Wichita, Kansas

Rooks County, Sec. 12 Twp. 8S Rge. (E) 18 (W)

Location as "NE/CNW/SW" or footage from lines SE NE NE  
Lease Owner Whitestone Petroleum Corporation  
Lease Name L. G. MADDY Well No. 1  
Office Address 900 Vaughn Bldg., Dallas, Texas 75201  
Character of Well (completed as Oil, Gas or Dry Hole) Dry Hole  
Date well completed - - - - - 19- - - - -  
Application for plugging filed 10/10 1963  
Application for plugging approved 10/10 1963  
Plugging commenced 10/10 1963  
Plugging completed 10/10 1963  
Reason for abandonment of well or producing formation No commercial zones

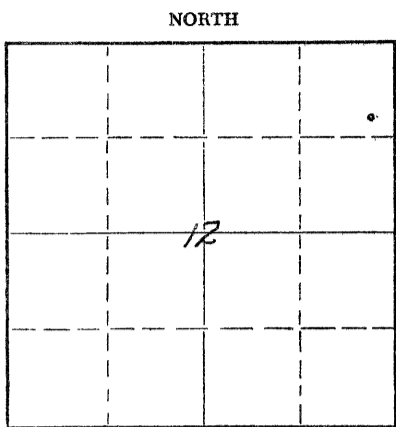

Locate well correctly on above Section Plat

If a producing well is abandoned, date of last production - - - - - 19- - - - -  
Was permission obtained from the Conservation Division or its agents before plugging was commenced? Yes

Name of Conservation Agent who supervised plugging of this well Eldon Petty, Hays, Kansas  
Producing formation - - - - - Depth to top - - - - - Bottom - - - - - Total Depth of Well 3455 Feet  
Show depth and thickness of all water, oil and gas formations.

OIL, GAS OR WATER RECORDS

CASING RECORD

FORMATION	CONTENT	FROM	TO	SIZE	PUT IN	PULLED OUT

Describe in detail the manner in which the well was plugged, indicating where the mud fluid was placed and the method or methods used in introducing it into the hole. If cement or other plugs were used, state the character of same and depth placed, from - - - - - feet to - - - - - feet for each plug set.

Hole filled with 10.2#/gallon drilling mud and 20-sacks cement plug with 1/2 sack cottonseed hulls at 540'. Second 20-sack cement plug with 1/2 sack cottonseed hulls placed at 170'. Third plug of 10 sacks cement plus 1/2 sack hulls placed from 40' to surface of the ground. Cement plugs placed in hole through drill pipe.

RECEIVED  
STATE CORPORATION COMMISSION

OCT 18 1963

10-18-1963

CONSERVATION DIVISION  
Wichita, Kansas

(If additional description is necessary, use BACK of this sheet)  
Name of Plugging Contractor Halliburton Company  
Address Hays, Kansas

STATE OF TEXAS, COUNTY OF DALLAS, ss.  
Dale O. Chase (employee of owner) or ~~(XXXXXX)~~ of the above-described well, being first duly sworn on oath, says: That I have knowledge of the facts, statements, and matters herein contained and the log of the above-described well as filed and that the same are true and correct. So help me God.

(Signature) Dale O. Chase  
900 Vaughn Bldg., Dallas, Texas  
(Address)

SUBSCRIBED AND SWORN TO before me this 17th day of October, 1963

My commission expires 6/1/65

Emmalee P. ...  
Notary Public.



WELL LOG

15-163-02647-00-00

COMPANY Whitestone Petroleum Corporation

SEC. 12 T. 8S R. 18W  
LOC. SE NE NE

FARM L. G. Maddy NO. 1

RIG. NO. 11

TOTAL DEPTH 3455'

COUNTRY **Rooks**  
KANSAS


COMM. 10-1-63

COMP. 10-10-63

SHOT OR TREATED

CONTRACTOR **Murfin Drilling Company**

ISSUED

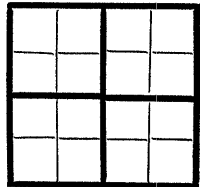

CASING

20 10  
15 8 5/8" @ 176' w/175 sacks  
12 6  
13 5

ELEVATION

PRODUCTION **D & A**

FIGURES INDICATE BOTTOM OF FORMATIONS

40	Rock Clay
75	Shale
90	Sand
520	Shale
805	Shald & Sand Streaks
1000	Sand
1100	Shale, Red Bed
1292	Red Bed
1328	Anhydrite
1890	Shale & Shells
2185	Shale & Lime
2542	Lime & Shale
2872	Shale & Lime
3145	Lime & Shale
3418	Lime
3439	Chert & Shale
3455	Arbuckle
3455	RTD

RECEIVED  
STATE CORPORATION COMMISSION

NOV 20 1963  
11-20-1963  
CONSERVATION DIVISION  
Wichita, Kansas

State of KANSAS  
County of SEDGWICK } ss:

I, W. R. Murfin of the Murfin Drilling Company

upon oath state that the above and foregoing is a true and correct copy of the log of the Maddy #1 well.

W. R. Murfin  
W. R. Murfin

Subscribed and sworn to before me this 17th day of October 1963

My Commission Expires: ADELA MIZENER, Notary Public  
My commission expires November 5, 1966

Adela Mizener  
NOTARY PUBLIC