

STATE OF KANSAS  
 STATE CORPORATION COMMISSION  
 200 Colorado Derby Bldg.  
 Wichita, Kansas 67202


Form CP-4  
 Rev. 12-15-80

WELL PLUGGING RECORD

Give All Information Completely  
 Make Required Affidavit

15-163-21699-00-00

COUNTY Rooks SEC. 13 TWP. 8S RGE. 18W /E/W  
 Location as in quarters or footage from lines:  
NE/4 NW/4 SW/4

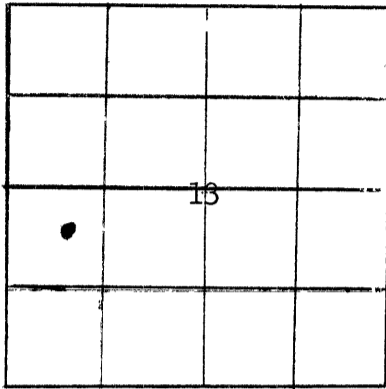

Locate Well  
 correctly on above  
 Section Plat.

Lease Owner Frontier Oil Company  
 Lease Name Hilgers "C" Well No. 1  
 Office Address 1720 KSB Building, Wichita, Kansas 67202  
 Character of Well (Completed as Oil, Gas or Dry Hole): Dry Hole  
 Date Well Completed June 3, 1982  
 Application for plugging filed June 3, 1982  
 Plugging commenced June 3, 1982  
 Plugging completed June 3, 1982  
 Reason for abandonment of well or producing formation D & A

Was permission obtained from the Conservation Division or it's  
 Agent's before plugging was commenced? Yes

Name of Conservation Agent who supervised plugging of this well Gil Balthazor  
 Producing formation n/a Depth to top n/a bottom T.D. 3,429'  
 Show depth and thickness of all water, oil and gas formations.

OIL, GAS OR WATER RECORDS

Casing Record

Formation	Content	From	To	Size	Put in	Pulled Out
				8 5/8"	303.36'	-0-

Describe in detail the manner in which the well was plugged, indicating where the mud  
 fluid was placed and the method or methods used in introducing it into the hold. If cement  
 or other plugs were used, state the character of same and depth placed, from \_\_\_\_\_ feet  
 to \_\_\_\_\_ feet for each plug set.

Plugged hole  
 1st Plug @ 780' w/70 sx cement  
 2nd Plug @ 330' w/40 sx cement  
 Bridge Plug @ 40' w/10 sx cement to surface  
 10 sx Cement in Rathole

RECEIVED  
 STATE CORPORATION COMMISSION  
 JUN 17 1982  
 06-17-1982  
 WICHITA, KANSAS

(If additional description is necessary, use BACK of this sheet)  
 Name of Plugging Contractor Red Tiger Drilling Company  
1720 KSB Building, Wichita, Kansas 67202

STATE OF Kansas COUNTY OF Sedgwick, ss.  
 \_\_\_\_\_ (employee of owner) or (owner or operator) of the  
 above-described well, being first duly sworn on oath, says: That I have knowledge of the  
 facts, statements, and matters herein contained and the log of the above-described well as  
 filed and that the same are true and correct. So help me God.



(Signature) George A. Angle  
1720 Ks St Bank Bldg., Wichita, Ks  
 (Address) 67202

SUBSCRIBED AND SWORN TO before me this 14th day of June, 19 82

My Commission expires: 5-14-85

Jean Stocks  
 Notary Public.