

CARD MUST BE TYPED

State of Kansas **NOTICE OF INTENTION TO DRILL** (see rules on reverse side)

CARD MUST BE SIGNED

Starting Date: July 18, 1985
 month day year

API Number 15- 059-23,946-00-00

OPERATOR: License # 7115
 Name John T. Casady
 Address Box 63
 City/State/Zip Wellsville, KS 66092
 Contact Person same
 Phone 913-883-2670

SW, SE, SW Sec 29 Twp 15 S, Rge 21 ☒ East
 (location) ☐ West

165 Ft North from Southeast Corner of Section
 3795 Ft West from Southeast Corner of Section
 (Note: Locate well on Section Plat on reverse side)

CONTRACTOR: License # 6913
 Name Casady Drilling Co.
 City/State Ottawa, KS

Nearest lease or unit boundary line 1485 feet.
 County Franklin
 Lease Name Moldenhauer Well# 18B

Domestic well within 330 feet: ☐ yes ☒ no
 Municipal well within one mile: ☐ yes ☒ no

Well Drilled For: Well Class: Type Equipment:
☒ Oil ☐ Swd ☒ Infield ☐ Mud Rotary
☐ Gas ☐ Inj ☐ Pool Ext. ☒ Air Rotary
☐ OWWO ☐ Expl ☐ Wildcat ☐ Cable
 If OWWO: old well info as follows:
 Operator
 Well Name
 Comp Date Old Total Depth
 Projected Total Depth 770 feet
 Projected Formation at TD Cherokee
 Expected Producing Formations Squirrel
 Depth to Bottom of fresh water none 60 feet
 Lowest usable water formation none
 Depth to Bottom of usable water 200 feet
 Surface pipe by Alternate: 1 ☐ 2 ☒
 Surface pipe to be set 20 feet
 Conductor pipe if any required n/a feet
 Ground surface elevation feet MSL
 This Authorization Expires 12-26-85
 Approved By 6-26-85

I certify that we will comply with K.S.A. 55-101, et seq., plus eventually plugging hole to K.C.C. specifications.

Date 23 June 85

Signature of Operator or Agent


Title

Owner

RECEIVED
STATE CORPORATION COMMISSION

JUN 26 1985

CONSERVATION DIVISION
Wichita, Kansas
A Regular Section of Land
1 Mile = 5,280 Ft.

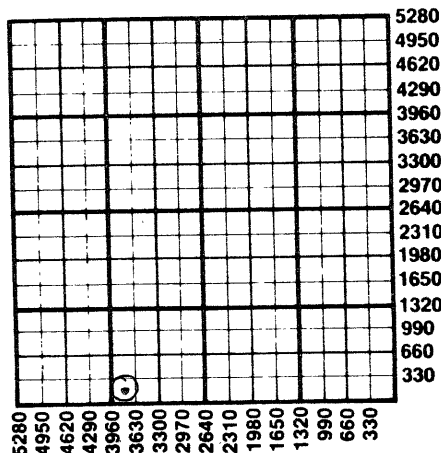

Must be filed with the K.C.C. five (5) days prior to commencing well
This card void if drilling not started within six (6) months of date received by K.C.C.

6-26-85

Important procedures to follow:

1. Notify District office before setting surface casing.
2. Set surface casing by circulating cement to the top.
3. File completion forms ACO-1 with K.C.C. within 90 days of well completion, following instructions on ACO-1, side 1, and including copies of wireline logs.
4. Notify District office 48 hours prior to old well workover or re-entry.
5. Prior to plugging, prepare a plugging plan, then obtain agreement from the appropriate district office for an approved plugging plan.
6. Submit plugging report (CP-4) to K.C.C. after plugging is completed.
7. Obtain an approved injection docket number before disposing of salt water.
8. Notify K.C.C. within 10 days when injection commences or terminates.
9. If an alternate 2 completion, cement in the production pipe from below any usable water to surface within 120 days of spud date.

State Corporation Commission of Kansas
Conservation Division
200 Colorado Derby Building
Wichita, Kansas 67202
(316) 263-3238