

CARD MUST BE SIGNED

API Number 15-

app.

.. NW NE .NW... Sec .1... Twp .16... S, Rge .20...
(location)

Phone ...913.242.7310...

City/State Rt. 2 Ottawa, KS 66067

☐ **Cable**

Expected Producing Formations

Title As agent

...4785..... Ft North from Southeast Corner of Section
...3465..... Ft West from Southeast Corner of Section
(Note: Locate well on Section Plat on reverse side)

Nearest lease or unit boundary line495..... feet.

County ... Franklin ... feet.

Lease Name Crawford Well# 1

Domestic well within 330 feet : ☐ yes ☒ no

Municipal well within one mile : ☐ yes ☒ no

Depth to Bottom of fresh waternone..... feet

Lowest usable water formation ... Douglas Group

Depth to Bottom of usable water 200 feet

Surface pipe by Alternate : 1 ☐ 2 ☒

Surface pipe to be set 40 **feet**

Conductor pipe if any required feet

Ground surface elevation feet **MSL**

This Authorization Expires 1-1-86 D

Approved By 7-1-85 

Must be filed with the K.C.C. five (5) days prior to commencing well
This card void if drilling not started within six (6) months of date received

RECEIVED
STATE CORPORATION COMMISSION

7-1-85

RECEIVED

JUL 01 1985


JUL 1 1985

Important procedures to follow:
CONSERVATION DIVISION
Wichita, Kansas

A Regular Section of Land
1 Mile = 5,280 Ft.

CONSERVATION DIVISION
Wichita, Kansas

1. Notify District office before setting surface casing.
2. Set surface casing by circulating cement to the top.
3. File completion forms ACO-1 with K.C.C. within 90 days of well completion, following instructions on ACO-1, side 1, and including copies of wireline logs.
4. Notify District office 48 hours prior to old well workover or re-entry.
5. Prior to plugging, prepare a plugging plan, then obtain agreement from the appropriate district office for an approved plugging plan.
6. Submit plugging report (CP-4) to K.C.C. after plugging is completed.
7. Obtain an approved injection docket number before disposing of salt water.
8. Notify K.C.C. within 10 days when injection commences or terminates.
9. If an alternate 2 completion, cement in the production pipe from below any usable water to surface within 120 days of spud date.

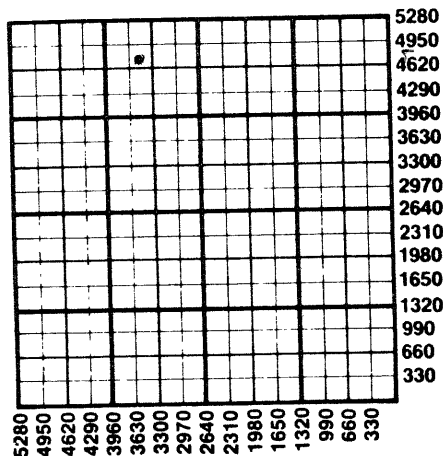

State Corporation Commission of Kansas
Conservation Division
200 Colorado Derby Building
Wichita, Kansas 67202
(316) 263-3238