

CARD MUST BE TYPED

State of Kansas
NOTICE OF INTENTION TO DRILL
(see rules on reverse side)

CARD MUST BE SIGNED

Starting Date: 11 15 84
month day year

API Number 15- 059-23,774-00-00

OPERATOR: License # 6807
Name Oil Drillers, Dev., Inc.
Address 7929 S.W. 29th St.
City/State/Zip Topeka, KS 66614
Contact Person Dr. Jerry Fegan
Phone 913 354 9591 (X388 Irene)

NW SW/NW Sec. 1. Twp. 16. S, Rge. 20. East
(location) West
..... 3895 Ft North from Southeast Corner of Section
..... 5115 Ft West from Southeast Corner of Section
(Note: Locate well on Section Plat on reverse side)

CONTRACTOR: License #
Name Company Tools
City/State

Nearest lease or unit boundary line 165 feet.
County Franklin
Lease Name Edward Seyler Well# 1

Well Drilled For: Well Class: Type Equipment:
 Oil Swd Infield Mud Rotary
 Gas Inj Pool Ext. Air Rotary
 OWWO Expl Wildcat Cable

Domestic well within 330 feet: yes no
Municipal well within one mile: yes no

If OWWO: old well info as follows:

Operator
Well Name
Comp Date Old Total Depth
Projected Total Depth 1350 feet
Projected Formation at TD
Expected Producing Formations

Depth to Bottom of fresh water 150 feet
Lowest usable water formation
Depth to Bottom of usable water 500-200 feet
Surface pipe by Alternate: 1 2
Surface pipe to be set 20 feet
Conductor pipe if any required feet
Ground surface elevation feet MSL
This Authorization Expires 5-15-85
Approved By 11-15-84 R

I certify that we will comply with K.S.A. 55-101, et seq., plus eventually plugging hole to K.C.C. specifications.

Date 11/15/84 Signature of Operator or Agent

Raqueel Robles

Title As agent

Form C-1 4/84

m hc/wohe 11/15/84

Must be filed with the K.C.C. five (5) days prior to commencing well
 This card void if drilling was started within six (6) months of date received by K.C.C.


CONSERVATION DIVISION

NOV 5 1984

11-15-84

Important procedures to follow :

A Regular Section of Land
 1 Mile = 5,280 Ft.

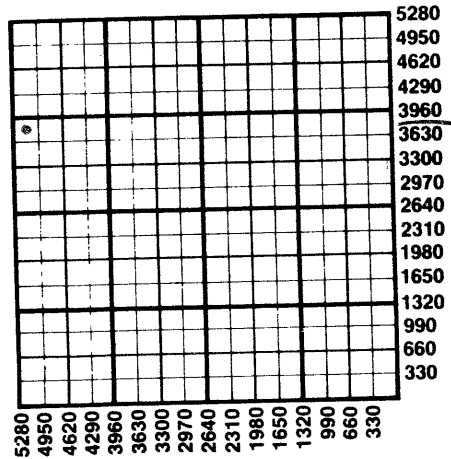

1. Notify District office before setting surface casing.
2. Set surface casing by circulating cement to the top.
3. File completion forms ACO-1 with K.C.C. within 90 days of well completion, following instructions on ACO-1, side 1, and including copies of wireline logs.
4. Notify District office 48 hours prior to old well workover or re-entry.
5. Prior to plugging, prepare a plugging plan, then obtain agreement from the appropriate district office for an approved plugging plan.
6. Submit plugging report (CP-4) to K.C.C. after plugging is completed.
7. Obtain an approved injection docket number before disposing of salt water.
8. Notify K.C.C. within 10 days when injection commences or terminates.
9. If an alternate 2 completion, cement in the production pipe from below any usable water to surface within 120 days of spud date.

State Corporation Commission of Kansas
 Conservation Division
 200 Colorado Derby Building
 Wichita, Kansas 67202
 (316)263-3238