


STATE OF KANSAS
 STATE CORPORATION COMMISSION
 Give All-Information Completely
 Make Required Affidavit
 Mail or Deliver Report to:
 Conservation Division
 State Corporation Commission
 300 Bitting Building
 Wichita, Kansas

OR
FORMATION PLUGGING RECORD Strike out upper line when reporting plugging off formations.

Rooks County. Sec. 18 Twp. 8 Rge. (E) 18 (W)
 Location as "NE 1/4 NW 1/4 SW 1/4" or footage from lines. NE NW NW
 Lease Owner Virginia Drilling Company, Inc.
 Lease Name Bouchey Well No. 1
 Office Address 701 Brown Building, Wichita 2, Kansas
 Character of Well (completed as Oil, Gas or Dry Hole) Dry hole
 Date well completed July 15 1949
 Application for plugging filed July 15 1949
 Application for plugging approved July 15 1949
 Plugging commenced July 15 1949
 Plugging completed July 15 1949
 Reason for abandonment of well or producing formation Dry hole

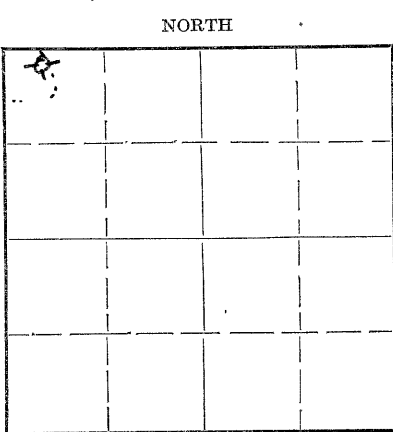

Locate well correctly on above Section Plat

If a producing well is abandoned, date of last production 19
 Was permission obtained from the Conservation Division or its agents before plugging was commenced? yes
 Name of Conservation Agent who supervised plugging of this well C. D. Stough
 Producing formation Depth to top Bottom Total Depth of Well 3494 Feet
 Show depth and thickness of all water, oil and gas formations.

OIL, GAS OR WATER RECORDS CASING RECORD

Formation	Content	From	To	Size	Put In	Pulled Out
				8-5/8	107	none

Describe in detail the manner in which the well was plugged, indicating where the mud fluid was placed and the method or methods used in introducing it into the hole. If cement or other plugs were used, state the character of same and depth placed, from feet to feet for each plug set.
 Filled hole with mud to 105'. Set wooden plug and dumped 15 sacks cement.
 Filled hole with mud to 25'. Dumped 10 sacks cement.

7-22-49

(If additional description is necessary, use BACK of this sheet)
 Correspondence regarding this well should be addressed to Virginia Drilling Company, Inc.
 Address 701 Brown Building, Wichita 2, Kansas


STATE OF Kansas, COUNTY OF Sedgwick, ss.
 S. A. Murphy (employee of owner) or (owner or operator) of the above-described well,

being first duly sworn on oath, says: That I have knowledge of the facts, statements, and matters herein contained and the log of the above-described well as filed and that the same are true and correct. So help me God.

(Signature) *S. A. Murphy*
 701 Brown Building, Wichita 2, Kansas
 (Address)

SUBSCRIBED AND SWORN to before me this 19th day of July, 19 49
Murphy
 Notary Public.

My commission expires 2/5/53

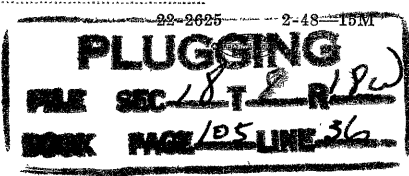

Name: Bouchey No. 1
 Location: NE NW NW Section 18-8S-18W, Rooks County, Kansas
 Company: Virginia Drilling Company, Inc.
 Contractor: Virginia Drilling Company, Inc.
 Commenced: June 30, 1949
 Completed: July 15, 1949
 Total Depth: 3494
 Elevation: 2008

FORMATION	DEPTH	CIRC. @
Shale	0-107	3179 - 1 hr.
Shale-shells	107-459	3418 - 1 hr. 14 min.
Shale-shells	459-550	3455 - 1 hr.
Sand	550-670	3462 - 1 hr.
Shale-shells	670-1150	3477 - 30 min.
Shale	1150-1395	3490 - 1 hr.
Lime	1395-1460	
Shale	1460-1550	Set 8-5/8" csg. @ 107
Shale-lime streaks	1550-1620	
Shale-shells	1620-1945	
Shale-lime	1945-2115	TOPS:
Shale-shells	2115-2235	
Shale-lime	2235-2550	Kansas City 3156
Lime	2550-2665	Arbuckle 3456
Lime-shale	2665-2850	Granite wash 3481
Lime	2850-2920	
Lime-shale	2920-3179	
Lime	3179-3381	
Lime-shale	3381-3470	
Lime	3470-3494	

RECEIVED
 JUL 22 1949 7-22-49

Now comes S. A. Murphy, who states that he is familiar with the drilling of oil and gas wells and knows of his own knowledge that the Bouchey No. 1, located in the NE NW NW Section 18-8S-18W, Rooks County, Kansas, was drilled to a total depth of 3494 feet. Same was plugged and abandoned.

S. A. Murphy

Subscribed and sworn to before me this 21st day of July, 1949.

Wm. Lee Hawkins

My commission expires February 5, 1953.

PLUGGING
 SEC 18 T 8 R 18W
 105 36