


15-163-03819-00-00

STATE OF KANSAS
STATE CORPORATION COMMISSION

WELL PLUGGING RECORD

Give All Information Completely
Make Required Affidavit
Mail or Deliver Report to:
Conservation Division
State Corporation Commission
800 Bitting Building
Wichita, Kansas

Rooks County. Sec. 18 Twp. 8 Rge. (E) 18 (W)
Location as "NE/CNW/SW" or footage from lines. NE NE SE
Lease Owner. Westgate-Greenland Oil Company
Lease Name. Sweet Well No. 1
Office Address. 1009 Central Building, Wichita, Kansas
Character of Well (completed as Oil, Gas or Dry Hole). oil
Date well completed. October 4, 1950 19
Application for plugging filed. March 26, 1953 19
Application for plugging approved. March 26, 1953 19
Plugging commenced. March 30, 1953 19
Plugging completed. April 14, 1953 19
Reason for abandonment of well or producing formation. oil depletion

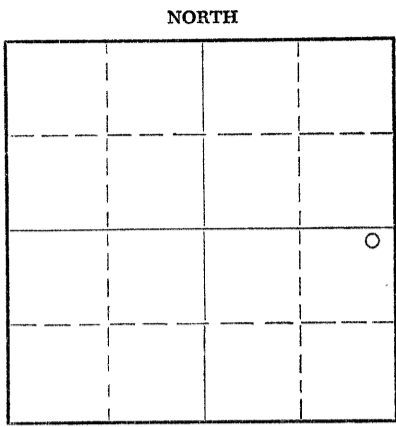

Locate well correctly on above
Section Plat

If a producing well is abandoned, date of last production. March 3, 1953 19
Was permission obtained from the Conservation Division or its agents before plugging was commenced? yes

Name of Conservation Agent who supervised plugging of this well. Eldon Petty
Producing formation. Depth to top. Bottom. Total Depth of Well. Feet
Show depth and thickness of all water, oil and gas formations.

OIL, GAS OR WATER RECORDS

CASING RECORD

FORMATION	CONTENT	FROM	TO	SIZE	PUT IN	PULLED OUT
Surface		0	169	8 5/8"	169	none
Arbuckle		0	3423	5 1/2"	3423	2780

Describe in detail the manner in which the well was plugged, indicating where the mud fluid was placed and the method or methods used in introducing it into the hole. If cement or other plugs were used, state the character of same and depth placed, from feet to feet for each plug set.

Filled hole with crushed rock from 3487 to 3400 feet
Ran 4 sacks cement from 3400 to 3370 feet
Filled with heavy mud from 3370 to 170 feet and bridged solid with rock.
Ran 15 sacks cement from 170 to 130 feet
Filled hole with heavy mud from 130 to 30 feet
Capped with 10 sacks cement from 30 feet to cellar base

RECEIVED
STATE CORPORATION COMMISSION
APR 27 1953
CONSERVATION DIVISION
WICHITA, KANSAS

(If additional description is necessary, use BACK of this sheet)
Name of Plugging Contractor. Morgan Well Plugging Service 4-27-53
Address. 102 West 18th Street, Hutchinson, Kansas

STATE OF Kansas, COUNTY OF Sedgwick, ss.
G. E. Bitler (employee of owner) or (owner or operator) of the above-described well, being first duly sworn on oath, says: That I have knowledge of the facts, statements, and matters herein contained and the log of the above-described well as filed and that the same are true and correct. So help me God.

(Signature) G. E. Bitler
1009 Central Building, Wichita, Ks
(Address)

SUBSCRIBED AND SWORN TO before me this 25th day of April, 19 53
Esther Russell
Notary Public.

My commission expires May 25, 1953.

PLUGGING
FILE SEC 18 T 8 R 18W
BOOK PAGE 87 LINE 27

15-163-03815-00-00

COMPANY: Westgate Greenland Oil Co.
 CONTRACTOR: Jackson Drilling Corporation
 FARM: Ruby Sweet #1
 LOCATION: NE NE SE Section 18-8-18W,
 Rooks County, Kansas
 ELEVATION: 1989
 COMMENCED: September 3, 1950
 COMPLETED: September 12, 1950 Rotary
 October 4, 1950 Cardwell

0	to	70	Shale and Shells
70	to	590	Shale
590	to	890	Shale and Sand
890	to	1100	Sand
1100	to	1385	Redbed and Shale
1385	to	1422	Anhydrite
1422	to	1800	Shale and Shells
1800	to	1845	Shale w/Salt Streaks
1845	to	2190	Lime and Shale
2190	to	2245	Shale and Shells
2245	to	2410	Shale and Lime
2410	to	2450	Lime
2450	to	3167	Lime and Shale
3167	to	3185	Lime
3185	to	3227	Lime w/Chert
3227	to	3423	Lime
3423	to	3431	Arbuckle
		3431 T.D. Rotary	
		3489 T.D. Cardwell	

8 5/8" 28# casing set at 169 feet. Cemented with 155 sacks cement and 2 sacks calcium chloride.
 5 1/2" casing set at 3425 feet. Cemented with 75 sacks cement.
 Drill stem test at 3431 - Open 1 hour - Recovered 60 feet slightly oil cut mud.
 1,000 gallons Dowell Service - 1 B.O.P.H. for 5 hours - 2,000 gallons

Tops: Anhydrite 1385
 Lansing 3167
 Heebner 3125
 Arbuckle 3418

Dry

All measurements from top of derrick floor.

C E R T I F I C A T E

I, Clare A. Stewart, do hereby certify that the above and foregoing is a true and correct copy of log of Ruby Sweet #1, Section 18-8-18W, Rooks County, Kansas, as reflected by files of the Jackson Drilling Corporation.

STATE

Clare A. Stewart
Clare A. Stewart

CONTRACTOR

Subscribed and sworn to before me, a Notary Public, within and for Johnson County, Kansas, this 13th day of October, 1950.

Dorothy J. Wilson
Dorothy J. Wilson

My Commission Expires November 30, 1950.

PLUGGING
 FILE SEC 18 T 8 R 18W
 BOOK PAGE 87 LINE 27