

15-163-00166-00-00

STATE OF KANSAS  
STATE CORPORATION COMMISSION


WELL PLUGGING RECORD

Give All Information Completely  
Make Required Affidavit  
Mail or Deliver Report to:  
Conservation Division  
State Corporation Commission  
800 Bitting Building  
Wichita, Kansas

OR  
FORMATION PLUGGING RECORD

Strike out upper line  
when reporting plugging  
off formations.

NORTH

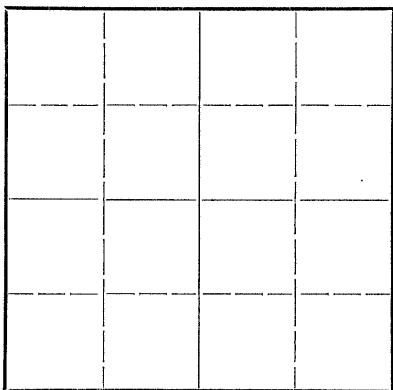

Locate well correctly on above  
Section Plat

Rooks County. Sec. 16 Twp. 8S Rge. 18(W)  
Location as "NE 1/4 NW 1/4 SW 1/4" or footage from lines. NW NW NW  
Lease Owner. Bay Petroleum Co. et al.  
Lease Name. Dickinson A. No. 1. Well No.  
Office Address. 914 Union National Bank Bldg., Wichita, Kansas.  
Character of Well (completed as Oil, Gas or Dry Hole) Dry hole  
Date well completed. 2-21-48 19  
Application for plugging filed. 2-21-48 19  
Application for plugging approved. 2-21-48 19  
Plugging commenced. 2-21-48 19  
Plugging completed. 2-22-48 19  
Reason for abandonment of well or producing formation  
If a producing well is abandoned, date of last production 19  
Was permission obtained from the Conservation Division or its agents before plugging was commenced? yes

Name of Conservation Agent who supervised plugging of this well  
Producing formation. Depth to top. Bottom. Total Depth of Well. Feet

Show depth and thickness of all water, oil and gas formations.

OIL, GAS OR WATER RECORDS

CASING RECORD

Formation	Content	From	To	Size	Put In	Pulled Out
				8"	238'	none

Describe in detail the manner in which the well was plugged, indicating where the mud fluid was placed and the method or methods used in introducing it into the hold. If cement or other plugs were used, state the character of same and depth placed, from feet to feet for each plug set.

pumped hole full of mud from 3560 to 238  
set wood plug at 238  
cemented with 15 sack cement  
filled with mud to 20 ft.  
set wood plug at 20 ft.  
cemented with 10 sack cement at 20'  
mud to surface

(If additional description is necessary, use BACK of this sheet)

Correspondence regarding this well should be addressed to Hinkle Oil Company  
Address 914 Union National Bank Building, Wichita, Kansas.

STATE OF Kansas, COUNTY OF Sedgwick, ss.

J. E. Hinkle (employee of owner) or (owner or operator) of the above-described well, being first duly sworn on oath, says: That I have knowledge of the facts, statements, and matters herein contained and the log of the above-described well as filed and that the same are true and correct. So help me God.

(Signature) J. E. Hinkle  
914 Union National Bank Bldg.,  
(Address)

SUBSCRIBED AND SWORN to before me this 1st day of March 19 48

My commission expires Jan. 17, 1950

Muriel A. Upton  
Notary Public.  
3-1948

22-237 7-47-10M

PLUGGING  
FILE SEC 16 T 8 R 8W  
BOOK PAGE 15 LINE 43

3-3-48

15-163-00166-00-00

casing record  
 238' 0" Completed  
 Dickinson A. No. 1. N<sup>W</sup> 20 W 15; S<sup>2</sup>, 15W, Sedgewick Co. Kansas.  
 Owner: Ray Petroleum Company, et al.  
 Contractor: J. E. Hinkle  
 2-9-48 Completed 2-21-48  
 Elevation 2003.

0	60	clay and gravel
60	110	clay and sand
110	238	lime and shale
238	290	shale
290	740	shale and shells
740	1200	sand and shale
1200	1775	shale and shells
1775	1415	anhydrite
1415	1900	shale and shells
1900	2225	lime and shale
2225	2338	cherty lime
2338	2380	lime
2380	2395	lime and shale
2395	2505	lime and shale
2505	2810	lime and shale
2810	2975	shale and shells & cherty lime
2975	2985	lime and shale
2985	2995	lime
2995	3170	lime and shale
3170	3205	shale
3205	3460	lime
3460	3506	lime and shale
3506	3560	lime

Beckler shale	3154
Dodge	3179
K. G.	3186
Lower K. G.	3435
Artucle	3507

State of Kansas )  
 )  
 County of Sedgewick )

I hereby certify that the above is a true and correct log as compiled from the daily drilling reports kept on said well.

J. B. Hinkle

Subscribed to and sworn to before me this 1st day of March, 1948.

Muril A. Upton  
N. J.

My commission expires 1-17-50

PLUGGING  
FILE SEC. 16 T 8 R 18 W  
BOOK PAGE 15 LINE 43