

This form shall be filed in duplicate with the Kansas Corporation Commission, 200 Colorado Derby Building, Wichita, Kansas 67202, within ten days after the completion of the well, regardless of how the well was completed.

Attach separate letter of request if the information is to be held confidential. If confidential, only file one copy. Information on side one will be of public record and side two will then be held confidential.

Circle one: Oil, Gas, Dry, SWD, OWVO, Injection. Type and complete ALL sections. Applications must be filed for dual completion, commingling, SWD and injection, T.A.

Attach wireline logs (i.e. electrical log, sonic log, gamma ray neutron log, etc.). KCC # (316) 263-3238. (Rules 82-2-105 & 82-2-125)


OPERATOR Black Petroleum Company #5068 API NO. 163-21,707-60-60
ADDRESS 200 W. Douglas, Suite 545 COUNTY Rooks
Wichita, Kansas 67202 FIELD Un-named CARROL J

\*\*CONTACT PERSON Thomas E. Black PROD. FORMATION
PHONE 316-264-9342 LEASE Ruby M. Byerly
PURCHASER NONE WELL NO. 1
ADDRESS None

RECEIVED STATE CORPORATION COMMISSION
None WELL LOCATION NE NE SW
DRILLING B & B Drilling, Inc. 330 Ft. from North Line and
CONTRACTOR 330 Ft. from East Line of
ADDRESS 515 Union Center the SW/4 SEC. 12 TWP. 8S RGE. 18W
Wichita, Kansas 67202

PLUGGING B & B Drilling, Inc.
CONTRACTOR
ADDRESS 515 Union Center
Wichita, Kansas 67202

TOTAL DEPTH 3337' PBTD
SPUD DATE 6/5/82 DATE COMPLETED 6/11/82
ELEV: GR 1869 DF 1875 KB 1877
DRILLED WITH (CANNEX) (ROTARY) KANIX TOOLS

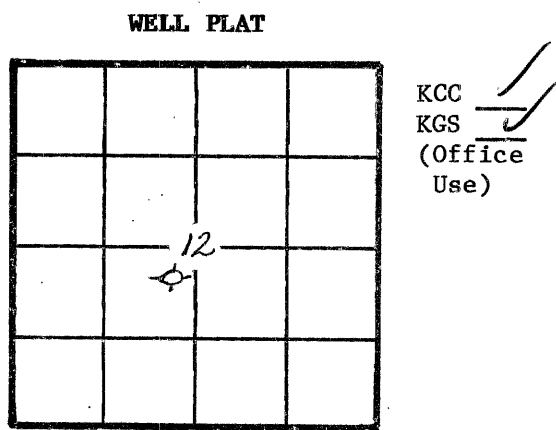

Amount of surface pipe set and cemented 251' with 160 sx DV Tool Used? No

AFFIDAVIT

STATE OF Kansas, COUNTY OF Sedgwick SS, I,
Thomas E. Black OF LAWFUL AGE, BEING FIRST DULY SWORN UPON HIS OATH,
DEPOSES THAT HE IS Owner (FOR)(OF) Black Petroleum Co.
OPERATOR OF THE Ruby M. Byerly LEASE, AND IS DULY AUTHORIZED TO MAKE
THIS AFFIDAVIT FOR AND ON THE BEHALF OF SAID OPERATOR, THAT WELL NO. 1 ON
SAID LEASE HAS BEEN COMPLETED AS OF THE 11th DAY OF June, 19 82, AND THAT
ALL INFORMATION ENTERED HEREIN WITH RESPECT TO SAID WELL IS TRUE AND CORRECT.
FURTHER AFFIANT SAITH NOT.

(S) Thomas E. Black

SUBSCRIBED AND SWORN BEFORE ME THIS 18th DAY OF June, 19 82.

MARTHA C. NUSSBAUM
NOTARY PUBLIC
STATE OF KANSAS
MY COMMISSION EXPIRES: 2-19-86

Martha C. Nussbaum
NOTARY PUBLIC

\*\*The person who can be reached by phone regarding any questions concerning this information. Within 45 days of completion, a witnessed initial test by the Commission is required if the well produces more than 25 BOPD or is located in a Basic Order Pool.

SIDE TWO

WELL LOG

Show all important zones of porosity and contents thereof; cored intervals, and all drill-stem tests, including depth interval tested, cushion used, time tool open, flowing and shut-in pressures, and recoveries.

SHOW GEOLOGICAL MARKERS, LOGS RUN, OR OTHER DESCRIPTIVE INFORMATION.

FORMATION DESCRIPTION, CONTENTS, ETC.	TOP	BOTTOM	NAME	DEPTH
Top Anhydrite	1260'			
Base Anhydrite	1296'			
Top Topeka	2807'			
Heebner Shale	3020'			
Toronto	3046'			
Lansing, KC	3064'			
Base KC	3284'			
<p>6-10-82 D. S. T. #1                      3154-3165' Open 60". Very weak blow. Dead in 15". Recovered 5' drilling mud.</p> <p>ICIP 106 in 30 min.                      FCIP 53 in 30 min.</p> <p>IFP 31-21 PSI                      FFP 53-53 PSI</p> <p>Temp 103 degrees</p>				

Report of all strings set— surface, intermediate, production, etc. CASING RECORD (New) ~~XXXXXX~~

Purpose of string	Size hole drilled	Size casing set (in O.D.)	Weight lbs/ft.	Setting depth	Type cement	Sacks	Type and percent additives
Surface	12 1/4	8 5/8"	20	251	Common	160	

LINER RECORD			PERFORATION RECORD		
Top, ft.	Bottom, ft.	Sacks cement	Shots per ft.	Size & type	Depth interval

TUBING RECORD		
Size	Setting depth	Packer set at

ACID, FRACTURE, SHOT, CEMENT SQUEEZE RECORD

Amount and kind of material used	Depth interval treated

Date of first production	Producing method (flowing, pumping, gas lift, etc.)	Gravity
RATE OF PRODUCTION PER 24 HOURS	Oil bbls.	Gas MCF
	Water %	Gas-oil ratio bbls. CFPB
Disposition of gas (vented, used on lease or sold)		Perforations