

CARD MUST BE TYPED

State of Kansas

CARD MUST BE SIGNED

### NOTICE OF INTENTION TO DRILL

(see rules on reverse side)

Starting Date .....6.....6.....86.....  
month day year 10:45

API Number 15— 121-26, 759-00-00

OPERATOR: License # .....9426.....  
Name .....Richard D. Taylor.....  
Address .....8029 Granada.....  
City/State/Zip .....Prairie Village, Kansas...66208  
Contact Person.....Liz Reusch.....  
Phone.....913-242-5733.....

APP. NE.NW.NW Sec..16. Twp..17. S, Rg...22.. — West  
.....49.30..... Ft. from South Line of Section  
.....4580..... Ft. from East Line of Section

(Note: Locate well on Section Plat on reverse side)

CONTRACTOR: License # .....4441.....  
Name .....Reusch Well Service, Inc.....  
City/State.....401 S. Main, Ottawa, KS. 66067

Nearest lease or unit boundary line .....350.... feet  
County.....Miami.....  
Lease Name.....Obermeier..... Well #..WW3.....  
Ground surface elevation .....n/a..... feet MSL

Well Drilled For: Well Class: Type Equipment:  
\_\_\_ Oil \_\_\_ SWD  Infield  Mud Rotary  
\_\_\_ Gas  Inj \_\_\_ Pool Ext. \_\_\_ Air Rotary  
\_\_\_ OWWO \_\_\_ Expl \_\_\_ Wildcat \_\_\_ Cable

Domestic well within 330 feet: \_\_\_ yes  no  
Municipal well within one mile: \_\_\_ yes  no  
Surface pipe by Alternate: 1 \_\_\_ 2  \_\_\_  
Depth to bottom of fresh water...17.....  
Depth to bottom of usable water .....300-200.....  
Surface pipe planned to be set .....20.....  
Projected Total Depth .....700..... feet  
Formation.....Squirrel.....

If OWWO: old well info as follows:

Operator .....  
Well Name .....  
Comp Date ..... Old Total Depth.....

I certify that well will comply with K.S.A. 55-101, et seq., plus eventually plugging hole to KCC specifications.

Date .....6-3-86. Signature of Operator or Agent ..... Title..... as agent.....

For KCC Use:

Conductor Pipe Required ..... feet; Minimum Surface Pipe Required ..... feet per Alt. 20

This Authorization Expires .....12-4-86. Approved By ..... 6-4-86

*Richard Taylor*


*[Signature]*

Must be filed with the K.C.C. five (5) days prior to commencing well  
 This card void if drilling not started within six (6) months of date received by K.C.C.

**Important procedures to follow:**

1. Notify District office before setting surface casing.
2. Set surface casing by circulating cement to the top.
3. File completion forms ACO-1 with K.C.C. within 90 days of well completion, following instructions on ACO-1, side 1, and including copies of wireline logs.
4. Notify District office 48 hours prior to old well workover or re-entry.
5. Prior to filing Intent, prepare a proposed plugging plan in case well is D & A, then obtain approval of plan when calling district office prior to setting surface pipe.
6. Submit plugging report (CP-4) to K.C.C. after plugging is completed.
7. Obtain an approved injection docket number before disposing of salt water.
8. Notify K.C.C. within 10 days when injection commences or terminates.
9. If an alternate 2 completion, cement in the production pipe from below any usable water to surface within 120 days of spud date.

**A Regular Section of Land**  
 1 Mile = 5,280 Ft.

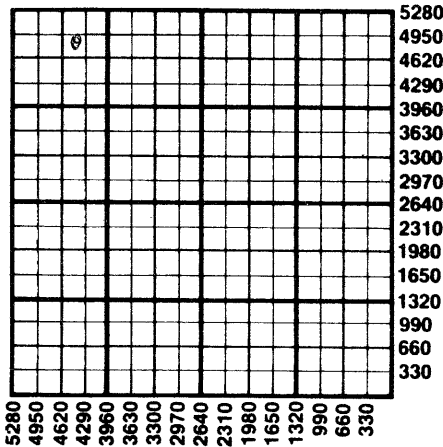

**RECEIVED**  
 STATE CORPORATION COMMISSION

06-04-86  
 JUN 4 - 1986

CONSERVATION DIVISION  
 Wichita Kansas

State Corporation Commission of Kansas  
 Conservation Division  
 200 Colorado Derby Building  
 Wichita, Kansas 67202  
 (316) 263-3238