


STATE OF KANSAS
STATE CORPORATION COMMISSION

15-163-00916-0000

Give All Information Completely
Make Required Affidavit
Mail or Deliver Report to:
Conservation Division
State Corporation Commission
211 No. Broadway
Wichita, Kansas

WELL PLUGGING RECORD

NORTH

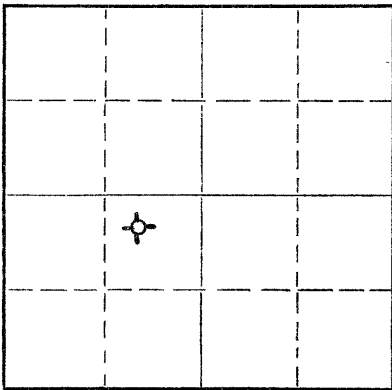

Locate well correctly on above
Section Plat

Rooks County. Sec. 29 Twp. 8 Rge. 17W (E) (W)
Location as "NE/CNW/SW" or footage from lines NW NE SW
Lease Owner D. G. Hansen
Lease Name Russ "A" Well No. 2
Office Address Logan, Kansas
Character of Well (completed as Oil, Gas or Dry Hole) Dry Hole
Date well completed June 20 19 59
Application for plugging filed June 20 19 59
Application for plugging approved June 20 19 59
Plugging commenced June 20 19 59
Plugging completed June 20 19 59
Reason for abandonment of well or producing formation Too low structually

If a producing well is abandoned, date of last production _____ 19 _____
Was permission obtained from the Conservation Division or its agents before plugging was commenced? Yes

Name of Conservation Agent who supervised plugging of this well Eldon Petty, Hays, Kansas
Producing formation _____ Depth to top _____ Bottom _____ Total Depth of Well 3455 Feet
Show depth and thickness of all water, oil and gas formations.

OIL, GAS OR WATER RECORDS

CASING RECORD

FORMATION	CONTENT	FROM	TO	SIZE	PUT IN	PULLED OUT
				8-5/8"	166.41'	none

Describe in detail the manner in which the well was plugged, indicating where the mud fluid was placed and the method or methods used in introducing it into the hole. If cement or other plugs were used, state the character of same and depth placed, from _____ feet to _____ feet for each plug set.


Filled hole with heavy mud to 600'. Set plug. Put in 20 sacks cement. Filled to 160'. Set plug. Put in 1/2 sack hulls and 15 sacks cement. Filled with heavy mud up to 40'. Set plug. Filled to top with 1/2 sack hulls and 10 sacks cement.

RECEIVED
CORPORATION COMMISSION
SEP 10 1959
RECEIVED
JUN 26 1959
D. G. HANSEN
Time.....

(If additional description is necessary, use BACK of this sheet)
Name of Plugging Contractor C-G Drilling Co. 9-10-59
Address 107 Rule Building, Wichita, Kansas

STATE OF KANSAS, COUNTY OF SEDGWICK, ss.
G. F. Galloway (employee of owner) or (owner or operator) of the above-described well, being first duly sworn on oath, says: That I have knowledge of the facts, statements, and matters herein contained and the log of the above-described well as filed and that the same are true and correct. So help me God.
(Signature) G. F. Galloway
107 Rule Building
(Address)

SUBSCRIBED AND SWORN TO before me this 22nd day of June, 1959
My commission expires May 20, 1963
Wicky Jacobs Notary Public.

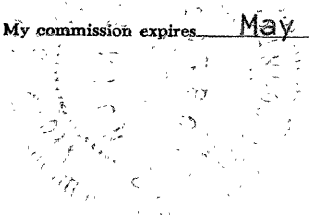

PLUGGING
File Sec. 29 T 8 R 17W
Book Page 1 Line 15

15-163-00916-00-00

WELL LOG

OPERATOR D. G. Hansen

SEC. 29-8-17W

WELL NAME Russ "A" #2

LOC. NW NE SW

TOTAL DEPTH 3455'

COUNTY Rooks

COMM. June 12, 1959

COMP. June 20, 1959

STATE Kansas

RIG NO. 1

ELEVATION 1955' K.B.

CASING: Ran 166.41' (9 jts.) 8-5/8" OD Surface Casing.

PRODUCTION: Producing

All measurements taken from the top of rotary bushing.

FROM	TO	FORMATION	DEVIATION FROM VERTICAL	REMARKS:
0	190	Sand-Shale		
190	890	Shale-Sand		
890	1010	Sand		
1010	1282	Red Bed		
1282	1323	Anhydrite		
1323	1890	Shale-Shell		
1890	2260	Shale-Lime		
2260	2390	Lime-Shale		
2390	2716	Shale-Lime		
2716	2823	Lime-Shale	0° - 2500	
2823	2930	Shale-Lime	0° - 2750	
2930	3020	Lime		
3020	3072	Lime-Shale	0° - 3000	
3072	3185	Lime		
3185	3190	Lime-Shale		DST 3149-3185'
3190	3310	Lime		
3310	3351	Lime-Shale	0° - 3250	
3351	3455	Lime		

RECEIVED STATE CORPORATION COMMISSION

SEP 10 1959

CONSERVATION DIVISION Wichita, Kansas

9-10-59

PLUGGING File Sec. 29 T. 8 R. 17W Book Page 1 Line 15

STATE OF KANSAS } COUNTY OF SEDGWICK } SS.

The undersigned hereby certifies that to the best of his knowledge and belief, the above facts are true and correct.

C-G DRILLING CO.

By G. F. Galloway

SUBSCRIBED AND SWORN TO, BEFORE ME, THIS 22nd day of June, 1959.

My commission expires: May 20, 1963

Vicky Jacobs Notary public