

15-163-20383-00-00

STATE OF KANSAS  
STATE CORPORATION COMMISSION


Form CP-4

Give All Information Completely  
Make Required Affidavit  
Mail or Deliver Report to:  
Conservation Division  
State Corporation Commission  
212 No. Market  
Wichita, Kansas 67202

WELL PLUGGING RECORD

Rooks County. Sec. 29 Twp. 8 Rge. 17 (E) W (W)  
Location as "NE/CNW%SW%" or footage from lines SE SE SW  
Lease Owner Black Petroleum, Inc.  
Lease Name Stamper Well No. 5  
Office Address Suite 445 Garvey Building  
Character of Well (completed as Oil, Gas or Dry Hole) Dry hole  
Date well completed 8-13 19 71  
Application for plugging filed 8-13 19 71  
Application for plugging approved 8-13 19 71  
Plugging commenced 8-13 19 71  
Plugging completed 8-13 19 71  
Reason for abandonment of well or producing formation Dry hole

NORTH

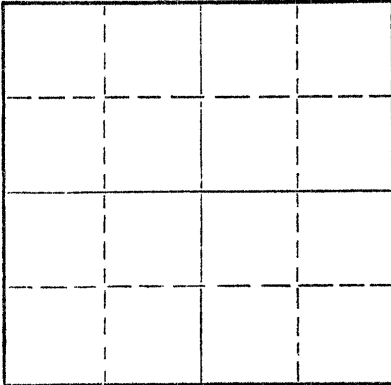

Locate well correctly on above  
Section Flat

If a producing well is abandoned, date of last production 19  
Was permission obtained from the Conservation Division or its agents before plugging was commenced? Yes

Name of Conservation Agent who supervised plugging of this well Leo Massey  
Producing formation \_\_\_\_\_ Depth to top \_\_\_\_\_ Bottom \_\_\_\_\_ Total Depth of Well 3,374 Feet  
Show depth and thickness of all water, oil and gas formations.

OIL, GAS OR WATER RECORDS

CASING RECORD

FORMATION	CONTENT	FROM	TO	SIZE	PUT IN	PULLED OUT
				8 5/8"	254'	Cmtd. w/175 sax

Describe in detail the manner in which the well was plugged, indicating where the mud fluid was placed and the method or methods used in introducing it into the hole. If cement or other plugs were used, state the character of same and depth placed, from \_\_\_\_\_ feet to \_\_\_\_\_ feet for each plug set.

Fill hole w/ heavy mud  
Set bridge plug @ 660'  
Pump 70 sax cement on plug thru 4 1/2" drill pipe  
Fill hole w/ heavy mud  
Set bridge plug @ 240'  
Pump 20 sax cement on plug thru 4 1/2" drill pipe  
Fill hole w/ heavy mud  
Set bridge plug @ 40' w/ 1/2 sax hulls on plug  
Dump 10 sax cement on plug to cellar

RECEIVED  
STATE CORPORATION COMMISSION  
SEP 1 1971  
CONSERVATION DIVISION  
Wichita, Kansas

9-1-71

(If additional description is necessary, use BACK of this sheet)

Name of Plugging Contractor Shields Drilling Company, Inc.  
Address Shields Building, Russell, Kansas

STATE OF Kansas, COUNTY OF Russell, ss.  
R. J. Shields (contractor) of the above-described well, being first duly sworn on oath, says: That I have knowledge of the facts, statements, and matters herein contained and the log of the above-described well as filed and that the same are true and correct. So help me God.

(Signature) R. J. Shields  
Shields Building, Russell, Kansas  
(Address)

SUBSCRIBED AND SWORN TO before me this 24th day of August, 19 71

Rush Phillips  
Notary Public.

My commission expires May 26, 1975



Shields


15-63-20383-00-00

Russell, Kansas

WELL LOG

Operator: Black Petroleum, Inc.  
 Well: Stamper #5  
 Commenced: August 6, 1971  
 Completed: August 13, 1971  
 Contractor: Shields Drilling Company, Inc.

Well Description: SE SE SW  
 Sec. 29-8S-17W  
 Rooks County, Kansas

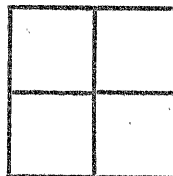

Elevation: 1,932' RB

Treatment:

Production: D & A

Tops:

CASING RECORD		
Size	Run	Pulled
8 5/8"	254'	Cmtd. w/175 sacks

..... Figures Indicate Bottom of Formations .....

Top soil, gravel & shale	260'
Shale	325'
Shale, sand & redbed	1,244'
Anhydrite	1,285'
Shale & shells	1,660'
Shale & lime	3,055'
Lime	3,374' RTD

RECEIVED  
 STATE CORPORATION COMMISSION  
 SEP 1 1971  
 CONSERVATION DIVISION  
 Wichita, Kansas  
 9-1-71

Notes