


15-163-00674-00-00

STATE OF KANSAS  
STATE CORPORATION COMMISSION  
Give All Information Completely  
Make Required Affidavit  
Mail or Deliver Report to:  
Conservation Division  
State Corporation Commission  
800 Biting Building  
Wichita, Kans.

### WELL PLUGGING RECORD

Rooks County. Sec. 30 Twp. 8 Rge. 17 (E) W (W)  
Location as "NE/CNW%SW%" or footage from lines NW NW SW  
Lease Owner C-G Drilling Co. and D. G. Hansen  
Lease Name Snyder Well No. 1  
Office Address 107 Rule Building, Wichita, Kansas  
Character of Well (completed as Oil, Gas or Dry Hole) Dry Hole  
Date well completed 9-12 1954  
Application for plugging filed 9-11 1954  
Application for plugging approved 9-11 1954  
Plugging commenced 9-12 1954  
Plugging completed 9-12 1954  
Reason for abandonment of well or producing formation Too low structurally

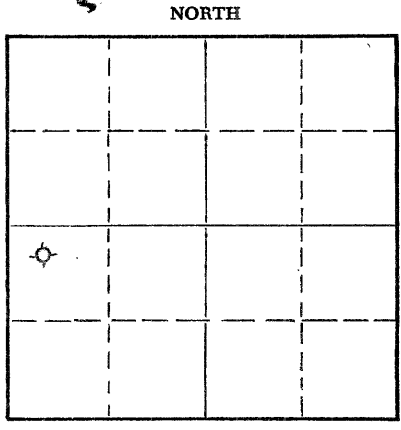

Locate well correctly on above Section Plat

If a producing well is abandoned, date of last production -- 19--  
Was permission obtained from the Conservation Division or its agents before plugging was commenced? Yes

Name of Conservation Agent who supervised plugging of this well Eldon Petty, Hays, Kansas  
Producing formation -- Depth to top -- Bottom -- Total Depth of Well 3430 Feet  
Show depth and thickness of all water, oil and gas formations.

#### OIL, GAS OR WATER RECORDS

#### CASING RECORD

FORMATION	CONTENT	FROM	TO	SIZE	PUT IN	PULLED OUT
				8-5/8"	177.65'	None

Describe in detail the manner in which the well was plugged, indicating where the mud fluid was placed and the method or methods used in introducing it into the hole. If cement or other plugs were used, state the character of same and depth placed, from    feet to    feet for each plug set.

Filled hole with mud to 170'; set plug; 1/2 sack hulls, 15 sacks cement. Filled hole w/ mud to 40'; set plug then filled to top w/ 10 sacks cement, 1/2 sack hulls.

RECEIVED  
STATE CORPORATION COMMISSION  
SEP 16 1954  
CONSERVATION DIVISION  
WICHITA, KANSAS

(If additional description is necessary, use BACK of this sheet)  
Name of Plugging Contractor C-G Drilling Co. 9-16-54  
Address 107 Rule Building, Wichita, Kansas

STATE OF KANSAS, COUNTY OF SEDGWICK, ss.  
Vicky Jacobs (employee of owner) or (owner or operator) of the above-described well, being first duly sworn on oath, says: That I have knowledge of the facts, statements, and matters herein contained and the log of the above-described well as filed and that the same are true and correct. So help me God.

(Signature) Vicky Jacobs  
107 Rule Building, Wichita, KS. Office Manager  
(Address)

SUBSCRIBED AND SWORN TO before me this 15th day of September, 1954

Barbara Donaldson  
Notary Public.

My commission expires June 17, 1957

**PLUGGING**  
FILE SEC 30 T 8 R 7W  
BOOK PAGE 63 LINE 36

15-1163-00674-00-00

CONTRACTOR'S WELL LOG

OPERATOR C-G Drilling Co. & D. G. Hansen FARM NAME Snyder #1  
LOCATION NW NW SW, Section 30-8-17W  
POOL NAME \_\_\_\_\_ COUNTY Rooks STATE Kansas  
COMMENCEMENT DATE September 4, 1954 COMPLETION DATE September 12, 1954

LOG OF WELL

Elevation: 1993 R.B.  
All measurements from the top of rotary bushing.

FROM	TO	FORMATION	DEVIATION FROM VERTICAL	REMARKS:
0	177	Sand-Shale		
177	845	Sand-Shale		
845	1020	Sand		
1020	1310	Red Bed		
1310	1348	Anhydrite		
1348	1700	Shale-Shells	0° - 1500'	
1700	2045	Shale-Shells	0° - 2000'	
2045	2320	Lime-Shale		
2320	2460	Lime-Shale		
2460	2590	Lime-Shale	0° - 2500'	
2590	2750	Lime-Shale		
2750	2905	Lime-Shale		
2905	2994	Lime-Shale		
2994	3065	Lime-Shale	0° - 3000'	
3065	3140	Lime-Shale		
3140	3205	Lime-Shale		
3205	3255	Lime-Shale		
3255	3306	Lime-Shale		
3306	3332	Lime-Shale		DST 3318-32
3332	3407	Shale		
3407	3417	Lime-Shale		DST 3411-17 3417-2
3417	3424	Lime		DST 3420-30
3424	3430	Lime		

CASING LEFT IN HOLE AFTER COMPLETION

Ran 177.65' (6 jts) of 8-5/8" Surface Casing.

STATE OF KANSAS }  
COUNTY OF SEDGWICK } ss.

The undersigned certifies that to the best of her knowledge and belief, the above facts are true and correct.

C-G DRILLING CO.

By Vicky Jacobs Office Manager

Subscribed and sworn to before me this 14th day of September, 1954.

My commission expires: June 17, 1957

Barbara Donaldson  
Notary Public

PLUGGING  
FILED SEC 30 8 R 7W  
BOOK PAGE 63 LINE 36