

15-163-20370-00-00

R

STATE OF KANSAS
STATE CORPORATION COMMISSION

WELL PLUGGING RECORD

Give All Information Completely
Make Required Affidavit
Mail or Deliver Report to:
Conservation Division
State Corporation Commission
212 No. Market
Wichita, Kansas

ROOKS

County. Sec. 30 Twp. 8 Rge. 17 (E) W (W)

Location as "NE/CNW/SW" or footage from lines N/2 S/2 N/2

Lease Owner DANEG. HANSEN TRUST

Lease Name BIRD

Well No. 15

Office Address LOGAN, KANSAS 67646

Character of Well (completed as Oil, Gas or Dry Hole) DRY HOLE

Date well completed MAY 22 19 71

Application for plugging filed MAY 22 19 71

Application for plugging approved MAY 22 19 71


Plugging commenced MAY 22 19 71

Plugging completed MAY 22 19 71

Reason for abandonment of well or producing formation TOO LOW STRUCTURALLY

If a producing well is abandoned, date of last production 19

Was permission obtained from the Conservation Division or its agents before plugging was commenced? YES

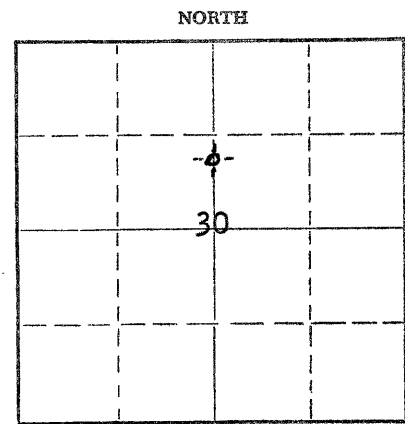

Locate well correctly on above Section Plat

Name of Conservation Agent who supervised plugging of this well LEO F MASSEY, HAYS, KANSAS

Producing formation Depth to top Bottom Total Depth of Well Feet

Show depth and thickness of all water, oil and gas formations.

OIL, GAS OR WATER RECORDS

CASING RECORD

FORMATION	CONTENT	FROM	TO	SIZE	PUT IN	PULLED OUT
				8-5/8"	187.93'	NONE

Describe in detail the manner in which the well was plugged, indicating where the mud fluid was placed and the method or methods used in introducing it into the hole. If cement or other plugs were used, state the character of same and depth placed, from feet to feet for each plug set.

FILLED WITH HEAVY MUD TO 720' SET PLUG. PUT IN 70 SACKS CEMENT. FILLED WITH HEAVY MUD TO 180'. SET PLUG. PUT in 20 SACKS CEMENT. FILLED WITH HEAVY MUD UP TO 40'. SET PLUG. FILLED TO TOP WITH 10 SACKS CEMENT.

RECEIVED
STATE CORPORATION COMMISSION
JUN 8 1971
CONSERVATION DIVISION
Wichita, Kansas

Name of Plugging Contractor C-G DRILLING CO. (If additional description is necessary, use BACK of this sheet)
Address 1107 UNION NATIONAL BUILDING, WICHITA, KANSAS 67202

STATE OF KANSAS COUNTY OF SEDGWICK ss.
G. F. GALLOWAY (employee of owner) or (owner or operator) of the above-described well, being first duly sworn on oath, says: That I have knowledge of the facts, statements, and matters herein contained and the log of the above-described well as filed and that the same are true and correct. So help me God.

(Signature) G. F. Galloway
1107 Union National Bldg.
(Address)

My commission expires to before me this 26th day of May, 19 71

DECEMBER 7, 1971
Phyllis Buchanan
Notary Public.

