


STATE OF KANSAS
STATE CORPORATION COMMISSION

Give All Information Completely
Make Required Affidavit
Mail or Deliver Report to:
Conservation Division
State Corporation Commission
211 No. Broadway
Wichita, Kansas

19-163-02644-00-00
WELL PLUGGING RECORD

NORTH

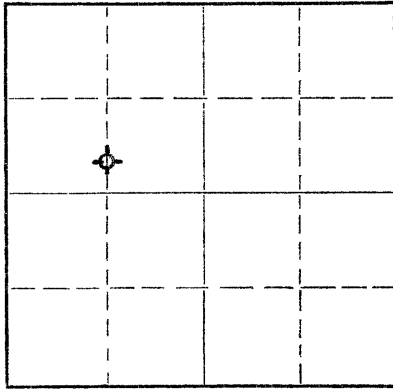

Locate well correctly on above
Section Plat

Rooks County, Sec. 30 Twp. 8 Rge. 17 (E) (W) W
Location as "NE/CNW/SW" or footage from lines S/2 S/2 NW/4
Lease Owner D. G. Hansen
Lease Name Bird Well No. 12
Office Address Logan, Kansas
Character of Well (completed as Oil, Gas or Dry Hole) Dry Hole
Date well completed June 30 19 60
Application for plugging filed June 30 19 60
Application for plugging approved June 30 19 60
Plugging commenced June 30 19 60
Plugging completed June 30 19 60
Reason for abandonment of well or producing formation Too low structurally

If a producing well is abandoned, date of last production 19
Was permission obtained from the Conservation Division or its agents before plugging was commenced? Yes

Name of Conservation Agent who supervised plugging of this well Eldon Petty, Hays, Kansas
Producing formation _____ Depth to top _____ Bottom _____ Total Depth of Well 3461' Feet
Show depth and thickness of all water, oil and gas formations.

OIL, GAS OR WATER RECORDS

CASING RECORD

FORMATION	CONTENT	FROM	TO	SIZE	PUT IN	PULLED OUT
				8-5/8"	172.11'	None

Describe in detail the manner in which the well was plugged, indicating where the mud fluid was placed and the method or methods used in introducing it into the hole. If cement or other plugs were used, state the character of same and depth placed, from _____ feet to _____ feet for each plug set.

Filled hole with heavy mud to 500'. Set plug. Put in 20 sacks cement. Filled to 160'. Set plug. Put in 1/2 sack hulls and 20 sacks cement. Filled with heavy mud up to 40'. Set plug. Filled to top with 1/2 sack hulls and 10 sacks cement.

RECEIVED
CONSERVATION DIVISION
Wichita, Kansas

(If additional description is necessary, use BACK of this sheet)
Name of Plugging Contractor C-G Drilling Co. 720-60
Address 107 Rule Building, Wichita 2, Kansas

STATE OF KANSAS COUNTY OF SEDGWICK, ss.
G. F. Galloway (employee of owner) or (owner or operator) of the above-described well, being first duly sworn on oath, says: That I have knowledge of the facts, statements, and matters herein contained and the log of the above-described well as filed and that the same are true and correct. So help me God.
(Signature) G. F. Galloway
107 Rule Building (Address)

SUBSCRIBED AND SWORN TO before me this 5th day of July, 1960

My commission expires May 20, 1963
Vicky Jacobs Notary Public



15-163-02044-00-00

W E L L L O G

OPERATOR D. G. Hansen SEC. 30-8-17W
 WELL NAME Bird #12 LOC. S/2 S/2 NW/4
 TOTAL DEPTH 3415' COUNTY Rooks
 COMM. June 22, 1960 COMP. June 30, 1960 STATE Kansas
 RIG NO. 1 ELEVATION 1967' K.B.
 CASING: Ran 172.11' (8 jts.) 8-5/8" OD Surface Casing. PRODUCTION: D & A

All measurements taken from the top of rotary bushing.

FROM	TO	FORMATION	DEVIATION FROM VERTICAL	REMARKS:
0	675	Sand-Shale		
675	810	Shale		
810	1010	Sand		
1010	1298	Shale-Red Bed		
1298	1340	Anhydrite		
1340	1450	Red Bed-Shale		
1450	1775	Shale		
1775	2175	Shale-Lime	0° - 2500	
2175	2900	Lime-Shale	0° - 2750	
2900	3005	Shale-Lime	0° - 3000	
3005	3123	Lime-Shale		DST 3098-3123'
3123	3225	Lime		DST 3198-3238'
3225	3240	Lime-Shale		
3240	3319	Lime	0° - 3250	DST 3279-3319'
3319	3361	Lime-Shale		
3361	3417	Lime		DST 3401-3415'
3417	3461	Lime-Shale		

RECEIVED
STATE CORPORATION COMMISSION

JUL 20 1960

COMMISSION DIVISION

7-20-60

STATE OF KANSAS }
 COUNTY OF SEDGWICK } SS.

The undersigned hereby certifies that to the best of his knowledge and belief, the above facts are true and correct.

C-G DRILLING CO.

By G. F. Galloway
G. F. Galloway

SUBSCRIBED AND SWORN TO, BEFORE ME, THIS 5th day of July, 1960.

My commission expires: May 20, 1963

Vicky Jacobs
Vicky Jacobs - Notary public