

15-163-30178-00-00

STATE OF KANSAS
STATE CORPORATION COMMISSION

WELL PLUGGING RECORD

Give All Information Completely
Make Required Affidavit
Mail or Deliver Report to:
Conservation Division
State Corporation Commission
211 No. Broadway
Wichita, Kansas

ROOKS

County. Sec. 30 Twp. 8S Rge. 17 (E) W (W)

Location as "NE/CNW/SW" or footage from lines C N LINE NW

Lease Owner DANE G HANSEN TRUST

Lease Name BIRD Well No. #13

Office Address LOGAN, KANSAS

Character of Well (completed as Oil, Gas or Dry Hole) DRY HOLE

Date well completed 1/10/66 19

Application for plugging filed 1/10/66 19

Application for plugging approved 1/10/66 19

Plugging commenced 1/10/66 19

Plugging completed 1/10/66 19

Reason for abandonment of well or producing formation TOO LOW STRUCTUALLY


If a producing well is abandoned, date of last production 19

Was permission obtained from the Conservation Division or its agents before plugging was commenced? YES

Name of Conservation Agent who supervised plugging of this well GILBERT LEIKER, HAYS, KANSAS

Producing formation Depth to top Bottom Total Depth of Well 3438 Feet

Show depth and thickness of all water, oil and gas formations.

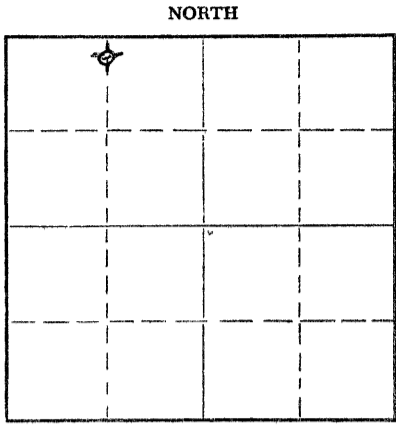

Locate well correctly on above Section Plat

OIL, GAS OR WATER RECORDS

CASING RECORD

FORMATION	CONTENT	FROM	TO	SIZE	PUT IN	PULLED OUT
				8-5/8"	164.36'	None

Describe in detail the manner in which the well was plugged, indicating where the mud fluid was placed and the method or methods used in introducing it into the hole. If cement or other plugs were used, state the character of same and depth placed, from feet to feet for each plug set.

Filled with heavy mud to 540'. Set plug. Put in 20 sx cement. Filled with heavy mud to 160'. Set plug. Put in 20 sx cement. Filled with heavy mud up to 40'. Set plug. Filled to top with 1/2 sx huls and 10 sx cement.

RECEIVED
STATE CORPORATION COMMISSION

JAN 24 1966

CONSERVATION DIVISION
WICHITA, KANSAS

1-24-66

(If additional description is necessary, use BACK of this sheet)

Name of Plugging Contractor C-G DRILLING CO.

Address 107 RULE BUILDING, WICHITA 2, KANSAS


STATE OF KANSAS, COUNTY OF SEDGWICK, ss. G. F. GALLOWAY

(employee of owner) or (owner or operator) of the above-described well, being first duly sworn on oath, says: That I have knowledge of the facts, statements, and matters herein contained and the log of the above-described well as filed and that the same are true and correct. So help me God.

(Signature) G. F. GALLOWAY
107 RULE BUILDING, WICHITA, KANSAS
(Address)

SUBSCRIBED AND SWORN to before me this 10th day of January, 1966

My commission expires MAY 20, 1967 VICKY JACOBS Notary Public.

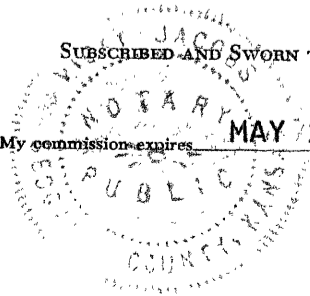

15-163-30178-00-00

RECEIVED
STATE OF KANSAS
COMMISSIONER OF REVENUE

JAN 24 1966

1-24-66

OFFICE OF THE COMMISSIONER OF REVENUE
WICHITA, KANSAS

W E L L L O G

OPERATOR: DANE G HANSEN TRUST

WELL NAME: BIRD #13 LOCATION: 30-8S-17W C N LINE NW

COUNTY: ROOKS STATE: KANSAS

WELL COMMENCED: 12/31/65 WELL COMPLETED: 1/10/66

ELEVATION: 1993' KB TOTAL DEPTH: 3438'

PRODUCTION: DRY & ABANDONED RIG NO: #1

CASING - 8-5/8": 8 jts., 164.36' w/140 sx cement.

5-1/2": _____

All Measurements taken from the top of rotary bushing.

FROM	TO	FORMATION	DEVIATION FROM VERTICAL	REMARKS:
0	164	Sand		
164	510	Shale	1/4°	450'
510	650	Sand & Shale		
650	735	Shale & Red Bed		
735	875	Shale		
875	1050	Sand	3/4°	1000'
1050	1305	Shale & Red Bed		
1305	1345	Anhydrite		
1345	1800	Shale & Shells	1/4°	1500'
1800	2010	Shale	1-1/4°	2000'
2010	3070	Lime & Shale	1°	2210'
3070	3416	Lime	1/2°	2540'
3416	3438	Arbuckle	1/4°	3040'

DST #1: 3110-3138'
DST #2: 3136-3160'
DST #3: 3225-3254'
DST #4: 3291-3320'
DST #5: 3410-3423'
DST #6: 3423-3438'

STATE OF KANSAS)
COUNTY OF SEDGWICK) SS:

The undersigned hereby certifies that to the best of his knowledge and belief, the above facts are true and correct.

C-G DRILLING CO.

BY

G. F. GALLOWAY

SUBSCRIBED AND SWORN TO, BEFORE ME, This 12th day of January, 1966.

My comm. exp: May 20, 1967

Vicky Jacobs
Vicky Jacobs - Notary Public

