

15-163-03774-00-00

STATE OF KANSAS
STATE CORPORATION COMMISSION

WELL PLUGGING RECORD

Give All Information Completely
Make Required Affidavit
Mail or Deliver Report to:
Conservation Division
State Corporation Commission
800 Bitting Building
Wichita, Kansas

OR
FORMATION PLUGGING RECORD

Strike out upper line
when reporting plug-
ging off formations.

Rooks County. Sec. 30 Twp. 8 Rge. 17 (W)

Location as "NE $\frac{1}{4}$ NW $\frac{1}{4}$ SW $\frac{1}{4}$ " or footage from lines S/2 SW/4 SE/4

Lease Owner The Harwood Oil Company

Lease Name Kennedy Well No. 1

Office Address 1008 Bitting Bldg., Wichita, Kansas

Character of Well (completed as Oil, Gas or Dry Hole) Dry hole

Date well completed September 25 1948

Application for plugging filed November 5 1948

Application for plugging approved November 5 1948


Plugging commenced November 11 1948

Plugging completed November 16 1948

Reason for abandonment of well or producing formation Dry hole

If a producing well is abandoned, date of last production 19

Was permission obtained from the Conservation Division or its agents before plugging was commenced? Yes

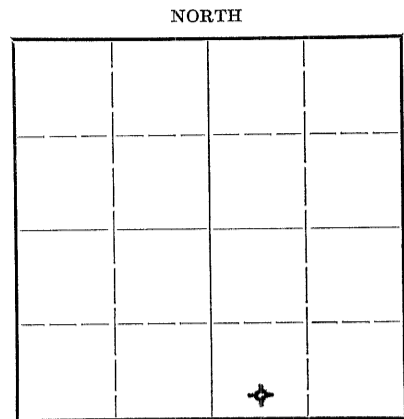

Locate well correctly on above
Section Plat

Name of Conservation Agent who supervised plugging of this well M. A. Lives

Producing formation Depth to top Bottom Total Depth of Well 3385 Feet

Show depth and thickness of all water, oil and gas formations.

OIL, GAS OR WATER RECORDS

CASING RECORD

Formation	Content	From	To	Size	Put In	Pulled Out
K. C. Lime	Oil & water	3101	3105	13"	215	None
K. C. Lime	Oil & water	3240	3243	5"	3384	2600
K. C. Lime	Oil & water	3254	3259			
K. C. Lime	Oil & water	3269	3280			
Simpson	Oil & water	3361	3364			
Arbuckle	Oil & water	3371	3379			

Describe in detail the manner in which the well was plugged, indicating where the mud fluid was placed and the method or methods used in introducing it into the hold. If cement or other plugs were used, state the character of same and depth placed, from feet to feet for each plug set.

Cement from T.D. to 3364
Lane-Wells bridging plug set at 3357
Lane-Wells bridging plug set at 3300
Cement from 3300 to 3290
Lane-Wells bridging plug set at 3140
Crushed rock from 3140 to 3095
Cement from 3095 to 3060
Heavy mud 3060 to 209
Rock bridge at 209
20 Sacks of cement on top of rock bridge
Heavy mud to 30 feet
15 Sacks of cement on top and in cellar.

RECORDED
NOV 18 1948
STATE CORPORATION COMMISSION
KANSAS

(If additional description is necessary, use BACK of this sheet)

Correspondence regarding this well should be addressed to The Harwood Oil Company
Address Box 1212, Wichita, Kansas

11-19-48

STATE OF KANSAS, COUNTY OF SEDGWICK, ss.
W. K. Harwood (employee of owner or operator) of the above-described well,
being first duly sworn on oath, says: That I have knowledge of the facts, statements, and matters herein contained and the log of the above-described well as filed and that the same are true and correct. So help me God.

(Signature) W. K. Harwood
Bitting Bldg., Wichita, Kansas (Address)

SUBSCRIBED AND SWORN to before me this 19th day of November, 1948

My commission expires 11-5-51
J. P. Roberts Notary Public.

3028 (174)
66 44

15-103-03774-00-00

May 20, 1948

Harwood Oil Company, et al
Wichita, Kansas

Contractor: STICKLE DRILLING COMPANY
Tulsa, Oklahoma

Commenced Drilling: May 2, 1948
Completed Drilling: May 16, 1948

Kennedy #1- C S/2- SW-SE-Section 30-8S-17W. Rooks County, Kansas.

LOG

Clay	0- 40
Sand	40- 60
Shale & Shells	60- 208
Shale, Sand & Shells	208- 500
Sand & Shale	500- 925
Red Bed	925-1100
Red Bed, Shale & Shells	1100-1255
Anhydrite	1255-1295
Shale, Shells & Red Bed	1295-1390
Shale & Shells	1390-1587
Salt	1587-1750
Shale & Lime	1750-1865
Broken Lime & Shale	1865-2030
Shale	2030-2115
Lime	2115-2325
Lime & Shale	2325-2450
Lime	2450-2555
Lime & Shale	2555-2860
Lime	2860-2955
Lime & Shale	2955-2995
Lime	2995-3233
Lime & Shale	3233-3275
Lime	3275-3359
Conglomerate	3359-3361
Lime	3361-3385 TD with Rotary

State of Oklahoma ()
County of Tulsa (SS)

I, Frank E. Stickle, do hereby certify, that the above is a true and complete log of the Harwood Oil Co. et-al. Kennedy #1 C S/2 - SW-SE-Section 30-8S-17W. Rooks County, Kansas

11-18-48

Frank E. Stickle
Frank E. Stickle

Sworn to and subscribed before me this 20th Day of May, 1948

Lillian T. Bonham
Notary Public

My Commission expires: Feb. 13, 1952

30 8 17W
66 44

RECEIVED

NOV 5 1948 11/5/1948
STATE CORPORATION
COMMISSION
KANSAS