

CARD MUST BE TYPED

State of Kansas NOTICE OF INTENTION TO DRILL

(see rules on reverse side)

CARD MUST BE SIGNED

Starting Date: June 1 1985
month day year

API Number 15- 163-22,698-00-00

OPERATOR: License # 5635
Name The Gene Brown Company
Address 407 S. Main
City/State/Zip Plainville, Kansas 67663
Contact Person Thomas E. Brown
Phone 913-434-4811

NW SE NW Sec 20 Twp 8 S, Rge 17
(location) East West

..3630..... Ft North from Southeast Corner of Section
..3630..... Ft West from Southeast Corner of Section
(Note: Locate well on Section Plat on reverse side)

CONTRACTOR: License # 9087
Name R. & C. Drilling Co., Inc.
City/State Hays, Kansas

Nearest lease or unit boundary line ~~300~~ 330 feet.

County Rooks

Lease Name Reeder Well# 2

Domestic well within 330 feet: yes no

Municipal well within one mile: yes no

Well Drilled For: Well Class: Type Equipment:
 Oil Swd Infield Mud Rotary
 Gas Inj Pool Ext. Air Rotary
 OWWO Expl Wildcat Cable

Depth to Bottom of fresh water 50 feet

Lowest usable water formation Dakota

Depth to Bottom of usable water 800 feet

Surface pipe by Alternate: 1 2

Surface pipe to be set 200 feet

Conductor pipe if any required -0- feet

Ground surface elevation NA feet MSL

This Authorization Expires 12-1-85

Approved By 5-31-85 *[Signature]*

If OWWO: old well info as follows:

Operator
Well Name
Comp Date Old Total Depth
Projected Total Depth 3400 feet
Projected Formation at TD Arbuckle
Expected Producing Formations Arbuckle

I certify that we will comply with K.S.A. 55-101, et seq., plus eventually plugging hole to K.C.C. specifications.

Date May 24, 1985 Signature of Operator or Agent

Mary Lou Brown Title

Office Manager

Form C-1 4/84

MHC/UCHE 5-31-85

Must be filed with the K.C.C. five (5) days prior to commencing well
 This card void if drilling not started within six (6) months of date received by K.C.C.

RECEIVED
 STATE CORPORATION COMMISSION

MAY 31 1985 5-31-85


Important procedures to follow:

RECEIVED
 STATE CORPORATION COMMISSION
 MAY 28 1985
 CONSERVATION DIVISION
 Wichita, Kansas

A Regular Section of Land
 1 Mile = 5,280 Ft.

CONSERVATION DIVISION
 Wichita, Kansas

1. Notify District office before setting surface casing.
2. Set surface casing by circulating cement to the top.
3. File completion forms ACO-1 with K.C.C. within 90 days of well completion, following instructions on ACO-1, side 1, and including copies of wireline logs.
4. Notify District office 48 hours prior to old well workover or re-entry.
5. Prior to plugging, prepare a plugging plan, then obtain agreement from the appropriate district office for an approved plugging plan.
6. Submit plugging report (CP-4) to K.C.C. after plugging is completed.
7. Obtain an approved injection docket number before disposing of salt water.
8. Notify K.C.C. within 10 days when injection commences or terminates.
9. If an alternate 2 completion, cement in the production pipe from below any usable water to surface within 120 days of spud date.

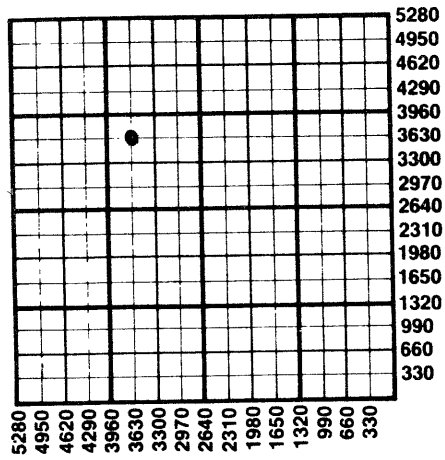

State Corporation Commission of Kansas
 Conservation Division
 200 Colorado Derby Building
 Wichita, Kansas 67202
 (316) 263-3238