

CARD MUST BE TYPED

State of Kansas

CARD MUST BE SIGNED

NOTICE OF INTENTION TO DRILL

(see rules on reverse side)

Starting Date 12 11 1985
month day year

API Number 15— 059-24, 112-00-00

OPERATOR: License # 5666

NE SE 1/4 Sec. 34 Twp. 15 S, Rg. 21 East

Name Finch's Drilling, Inc.

1815 Ft. from South Line of Section

Address RR 2 Box 125

495 Ft. from East Line of Section

City/State/Zip Ottawa, KS 66067

(Note: Locate well on Section Plat on reverse side)

Contact Person Gardner Finch

Phone 913-878-3332

Nearest lease or unit boundary line 495 feet

CONTRACTOR: License # 5666

County Franklin

Name Company Tools

Lease Name Johnson Well # 24

City/State

Ground surface elevation feet MSL

Well Drilled For: Well Class: Type Equipment:

Domestic well within 330 feet: yes no

Oil SWD Infield Mud Rotary

Municipal well within one mile: yes no

Gas Inj Pool Ext. Air Rotary

Surface pipe by Alternate: 1 2

OWWO Expl Wildcat Cable

Depth to bottom of fresh water. none 260

If OWWO: old well info as follows:

Depth to bottom of usable water 200'

Operator

Surface pipe planned to be set 21'

Well Name

Projected Total Depth 750 feet

Comp Date Old Total Depth

Formation Squirrel

I certify that well will comply with K.S.A. 55-101, et seq., plus eventually plugging hole to KCC specifications.

_____ cementing will be done immediately upon setting production casing

Date Signature of Operator or Agent Gardner, G. Finch Title (Pres)

For KCC Use:

Conductor Pipe Required feet; Minimum Surface Pipe Required feet per Alt. 2


This Authorization Expires 6-9-86 Approved By 12-9-85

Must be filed with the K.C.C. five (5) days prior to commencing well
 This card void if drilling not started within six (6) months of date received by K.C.C.

Important procedures to follow:

1. Notify District office before setting surface casing.
2. Set surface casing by circulating cement to the top.
3. File completion forms ACO-1 with K.C.C. within 90 days of well completion, following instructions on ACO-1, side 1, and including copies of wireline logs.
4. Notify District office 48 hours prior to old well workover or re-entry.
5. Prior to filing Intent, prepare a proposed plugging plan in case well is D & A, then obtain approval of plan when calling district office prior to setting surface pipe.
6. Submit plugging report (CP-4) to K.C.C. after plugging is completed.
7. Obtain an approved injection docket number before disposing of salt water.
8. Notify K.C.C. within 10 days when injection commences or terminates.
9. If an alternate 2 completion, cement in the production pipe from below any usable water to surface within 120 days of spud date.

A Regular Section of Land
1 Mile = 5,280 Ft.

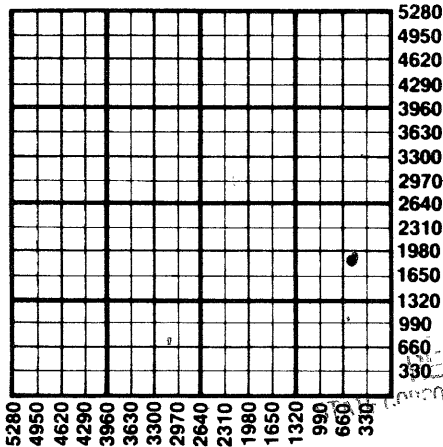

RECEIVED
 CORPORATION COMMISSION

DEC 9 1985

CONSERVATION DIVISION
 Wichita, Kansas

12-9-85

State Corporation Commission of Kansas
 Conservation Division
 200 Colorado Derby Building
 Wichita, Kansas 67202
 (316) 263-3238