

FOR KCC USE:

FORM 2-1 7/79

FORM MUST BE FILLED

FORM MUST BE FILLED

ALL BLANKS MUST BE FILLED

EFFECTIVE DATE: 5-14-95

DISTRICT: 4/

State of Kansas

NOTICE OF INTENTION TO DRILL

Must be approved by the K.C.C. five (5) days prior to commencing well.

Expected Spud Date: 6 month, 1 day, 95 year

Section: 29, Twp: 8, S. 1q: 17, East: X, West: X

OPERATOR: License #: 03218
Name: American Trading and Production Corp.
Address: 1331 Lamar, Suite 1250
City/State/Zip: Houston, Texas 77010
Contact Person: Donald W. Garrett
Phone: 713 / 658-0445

990 feet from South / North line of section
990 feet from East / West line of section

IS SECTION X REGULAR IRREGULAR

(NOTE: Locate well on the Section Plat on Reverse Side)

County: Rooks
Lease Name: Stamper "A" Well #: 10
Field Name: Dopita

CONTRACTOR: License #: Unknown
Name: Unknown at This Time

Is this a Pretest/Spaced Field? yes X no
Target Formation(s): Lansing-Kansas City

Nearest lease or unit boundary: 990'
Ground Surface Elevation: 1978 feet MSL

Well Drilled For: Well Class: Type Equipment:
X Oil X Enh Rec Infield X Mud Rotary
Gas Storage Pool Exp Air Rotary
CWD Disposal Wildcat Cable
Seismic: # of Holes Other

Water well within one-quarter mile: yes X no
Public water supply well within one mile: yes X no

Depth to bottom of fresh water: 75' 180'
Depth to bottom of usable water: 800' 880'

Surface Pipe by Alternate: X 1 2
Length of Surface Pipe Planned to be set: 1300'

Length of Conductor pipe required: None
Projected Total Depth: 3400'

Formation at Total Depth: Arbuckle
Water Source for Drilling Operations:

SWR Permit #: N/A well X farm pond other
Will cores be taken? N/A yes X no

If yes, proposed zone: N/A

If CWD: old well information as follows:
Operator: N/A
Well Name: N/A
Comp. Date: N/A Old Total Depth: N/A
Directional, Deviated or Horizontal wellbore? yes X no
If yes, true vertical depth: N/A
Bottom Hole Location: N/A

AFFIDAVIT

The undersigned hereby affirms that the drilling, completion and eventual plugging of this well will comply with 2,200-101, et. seq.
It is agreed that the following minimum requirements will be met:

RECEIVED STATE CORPORATION COMMISSION MAY 08 1995 5-8-1995 CONSERVATION DIVISION WICHITA, KANSAS

- 1. Notify the appropriate district office prior to spudding or well;
2. A copy of the approved notice of intent to drill shall be posted on each drilling rig;
3. The minimum amount of surface pipe as specified below shall be set by circulating cement to the top;
4. If the well is dry hole, an agreement between the operator and the district office on plug length and placement is necessary prior to plugging;
5. The appropriate district office will be notified before well is either plugged or production casing is cemented in;
6. IF AN ALTERNATE IS COMPLETED, PRODUCTION PIPE SHALL BE CEMENTED FROM BELOW ANY USABLE WATER TO SURFACE WITHIN 120 DAYS OF SPUD DATE. IN ALL CASES, NOTIFY DISTRICT OFFICE PRIOR TO ANY CEMENTING.

I hereby certify that the statements made herein are true and to the best of my knowledge and belief.
Date: April 21, 1995 Signature of Operator or Agent: Donald W. Garrett Title: Operations Manager

FOR KCC USE:
API # 15- 163-232590000
Conductor pipe required NONE feet
Minimum surface pipe required 900' feet per Alt. (X)
Approved by: JK 5-8-95
This authorization expires: 11-8-95
(This authorization void if drilling not started within 6 months of effective date.)
Spud date: Agent:

RELEASE TO:

- File Drill Site Application (Form 202-1) with Intent to Drill;
- File Completion Form 100-1 within 120 days of spud date;
- File screen attribution data according to field operation orders;
- Notify appropriate district office 48 hours prior to ventover or vententry;
- Submit plugging report (202-4) after plugging is completed;
- Obtain written approval before disposing or injecting salt water.

Mail to: Conservation Division, 200 Governor Jerry Building, 221 N. First St., Wichita, Kansas 67202-1236.

29 8 17W

IN ALL CASES PLOT THE INTENDED WELL ON THE PLAT BELOW

PLAT OF ACREAGE ATTRIBUTABLE TO A WELL IN A PRORATED OR SPACED FIELD

If the intended well is in a prorated or spaced field please fully complete this side of the form. If the intended well is in a prorated or spaced field complete the plat below showing that the well will be properly located in relationship to other wells producing from the common source of supply. Please show all the wells within 1 mile of the boundaries of the proposed acreage attribution unit for gas wells and within 1/2 mile of the boundaries of the proposed acreage attribution unit for oil wells.

API NO. 15- _____
 OPERATOR _____
 LEASE _____
 WELL NUMBER _____
 FIELD _____



LOCATION OF WELL: COUNTY _____
 _____ feet from south/north line of section
 _____ feet from east/west line of section
 SECTION _____ TWP _____ RG _____

NUMBER OF ACRES ATTRIBUTABLE TO WELL _____
 QTR/QTR/QTR OF ACREAGE _____

IS SECTION _____ REGULAR or _____ IRREGULAR
IF SECTION IS IRREGULAR LOCATE WELL FROM NEAREST CORNER BOUNDARY.

Section corner used: _____ NE _____ NW _____ SE _____ SW
PLAT

(Show location of the well and shade attributable acreage for prorated or spaced wells.)
 (Show footage to the nearest lease or unit boundary line.)

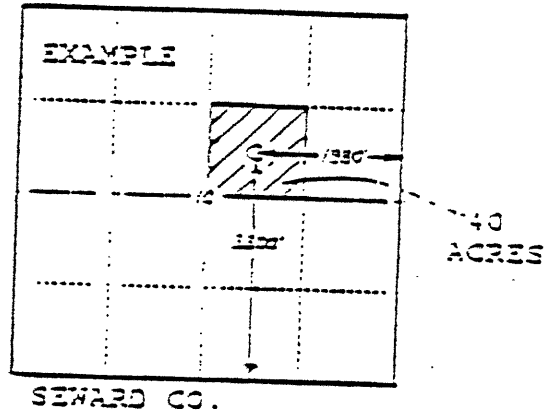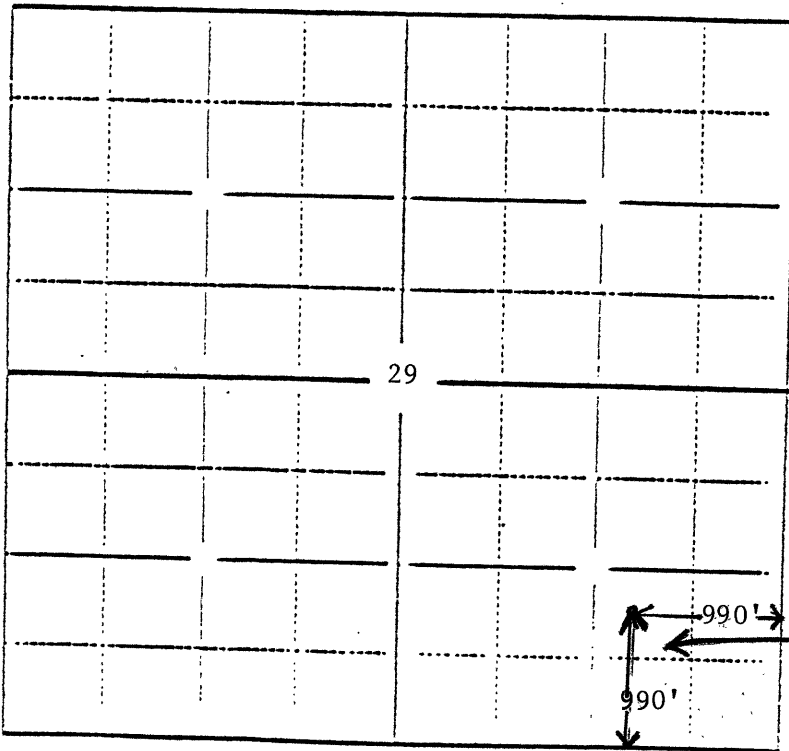

Rooks County

In plotting the proposed location of the well you must show:

- 1) The manner in which you are using the depicted plat by identifying section lines, i.e. 1 section 1 section with 3 surrounding sections, 4 sections, etc.;
- 2) the distance of the proposed drilling location from the section's south/north and east/west lines; and
- 3) the distance to the nearest lease or unit boundary line.