

CARD MUST BE TYPED

STATE OF KANSAS  
**NOTICE OF INTENTION TO DRILL**  
(see rules on reverse side)

CARD MUST BE SIGNED

Starting Date: May 25, 1985  
month day year

API Number 15- 121-26, 542-00-00  
SE SW  East  
SE SW (location) Sec. 29 Twp. 17 S. Rge. 22  West

OPERATOR: License # 6293  
Name Continental Exploration, Inc.  
Address 7315 Frontage, Suite 110  
City/State/Zip Shawnee Mission, KS 66204  
Contact Person William P. Moore, III  
Phone 913-384-2234

1,460.... Ft North from Southeast Corner of Section  
4,450.... Ft West from Southeast Corner of Section  
(Note: Locate well on Section Plat on reverse side)

CONTRACTOR: License # 6142  
Name Town Oil Company  
City/State Paola, KS 66071

Nearest lease or unit boundary line 490 feet.  
County Miami

Lease Name Feebeck #1 Well# 94

Domestic well within 330 feet :  yes  no

Municipal well within one mile :  yes  no

Well Drilled For: Well Class: Type Equipment:  
 Oil  Swd  Infield  Mud Rotary  
 Gas  Inj  Pool Ext.  Air Rotary  
 OWWO  Expl  Wildcat  Cable

Depth to Bottom of fresh water 45 feet

Lowest usable water formation .....

Depth to Bottom of usable water 200 feet

Surface pipe by Alternate : 1  2

Surface pipe to be set 20 feet

Conductor pipe if any required None feet

Ground surface elevation .....

This Authorization Expires 11-20-85

Approved By 5-20-85 PC

If OWWO: old well info as follows:

Operator .....

Well Name .....

Comp Date .....

Projected Total Depth 500 Old Total Depth .....

Projected Formation at TD Wayside

Expected Producing Formations Wayside

I certify that we will comply with K.S.A. 55-101, et seq., plus eventually plugging hole to K.C.C. specifications.

Date 5/16/85 Signature of Operator or Agent

PC Title President

WMC/MOHE 5-20-85 Form C-1 4/84


Must be filed with the K.C.C. five (5) days prior to commencing well  
 This card void if drilling not started within six (6) months of date received by K.C.C.

RECEIVED  
 STATE CORPORATION COMMISSION

Important procedures to follow:

MAY 20 1985

A Regular Section of Land  
 1 Mile = 5,280 Ft.

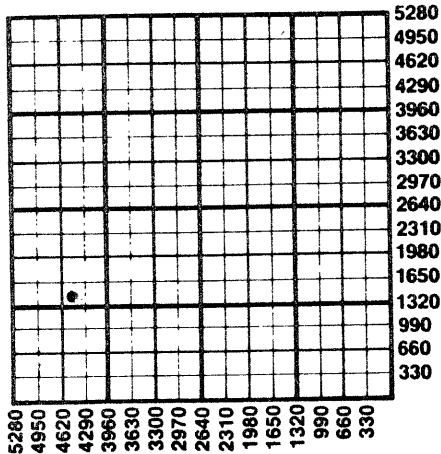

1. Notify District office before setting surface casing.
2. Set surface casing by circulating cement to the top of well as
3. File completion forms ACO-1 with K.C.C. within 90 days of well completion, following instructions on ACO-1, side 1, and including copies of wireline logs.
4. Notify District office 48 hours prior to old well workover or re-entry.
5. Prior to plugging, prepare a plugging plan, then obtain agreement from the appropriate district office for an approved plugging plan.
6. Submit plugging report (CP-4) to K.C.C. after plugging is completed.
7. Obtain an approved injection docket number before disposing of salt water.
8. Notify K.C.C. within 10 days when injection commences or terminates.
9. If an alternate 2 completion, cement in the production pipe from below any usable water to surface within 120 days of spud date.

State Corporation Commission of Kansas  
 Conservation Division  
 200 Colorado Derby Building  
 Wichita, Kansas 67202  
 (316) 263-3238