

CARD MUST BE TYPED

State of Kansas
NOTICE OF INTENTION TO DRILL 9-18-85 CARD MUST BE SIGNED
(see rules on reverse side)

****CORRECTED INTENT****

Starting Date:Sept..20..1985.....
month day year

API Number 15- 121-26,580-~~00~~

OPERATOR: License #6293.....
Name ..Continental Exploration, Inc.....
Address ..7315 Frontage Rd., #110.....
City/State/Zip ..Shawnee Mission, KS 66204.....
Contact Person ..Bill Moore.....
Phone913-384-2234.....

NE SW SW Sec .29 Twp 17 S, Rge 22 East
(location) West

CONTRACTOR: License #6142.....
Name ..Town Oil Company.....
City/State ..Paola, KS 66071.....

*.1,055..... Ft North from Southeast Corner of Section
**4,495..... Ft West from Southeast Corner of Section
(Note: Locate well on Section Plat on reverse side)

Nearest lease or unit boundary line **530 feet.
County ..Miami.....
Lease Name Feebeck #1 Well# 304.....

Domestic well within 330 feet: yes no
Municipal well within one mile: yes no

Well Drilled For: Well Class: Type Equipment:
 Oil Swd Infield Mud Rotary
 Gas Inj Pool Ext. Air Rotary
 OWWO Expl Wildcat Cable

Depth to Bottom of fresh water45..... feet
Lowest usable water formation
Depth to Bottom of usable water2.00..... feet
Surface pipe by Alternate: 1 2
Surface pipe to be set2.0..... feet
Conductor pipe if any requiredNone..... feet
Ground surface elevation feet MSL

If OWWO: old well info as follows:

Operator
Well Name
Comp Date Old Total Depth
Projected Total Depth500..... feet
Projected Formation at TDWayside.....
Expected Producing Formations ..Wayside.....

This Authorization Expires12-25-85.....
Approved By6-25-85.....
*Was 745 ***Was 495
**Was 4,465
President

I certify that we will comply with K.S.A. 55-101, et seq., plus eventually plugging hole to K.C.C. specifications.


Date 9/16/85 Signature of Operator or Agent

Title

**Must be filed with the K.C.C. five (5) days prior to commencing well
This card void if drilling not started within six (6) months of date received by K.C.C.**

Important procedures to follow :

**A Regular Section of Land
1 Mile = 5,280 Ft.**

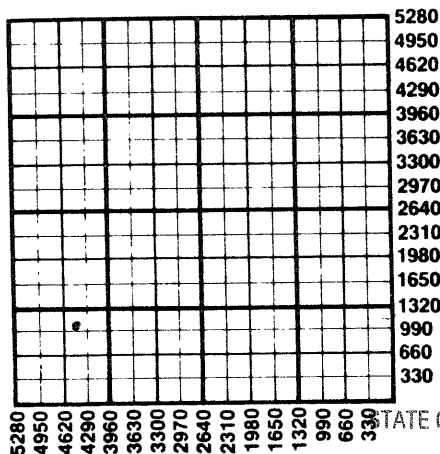

1. Notify District office before setting surface casing.
2. Set surface casing by circulating cement to the top.
3. File completion forms ACO-1 with K.C.C. within 90 days of well completion, following instructions on ACO-1, side 1, and including copies of wireline logs.
4. Notify District office 48 hours prior to old well workover or re-entry.
5. Prior to plugging, prepare a plugging plan, then obtain agreement from the appropriate district office for an approved plugging plan.
6. Submit plugging report (CP-4) to K.C.C. after plugging is completed.
7. Obtain an approved injection docket number before disposing of salt water.
8. Notify K.C.C. within 10 days when injection commences or terminates.
9. If an alternate 2 completion, cement in the production pipe from below any usable water to surface within 120 days of spud date.

RECEIVED

STATE CORPORATION COMMISSION

State Corporation Commission of Kansas

Conservation Division

200 Colorado Derby Building

Wichita, Kansas 67202

(316)263-3238

SEP 18 1985

CONSERVATION DIVISION
Wichita, Kansas