

CARD MUST BE TYPED

State of Kansas
NOTICE OF INTENTION TO DRILL
(see rules on reverse side)

CARD MUST BE SIGNED
CORRECTED INTENT

10-24-85

Starting Date October 7, 1985
month day year

API Number 15— 121-26,678-00-00
X East

OPERATOR: License # 6293
Name Continental Exploration, Inc.
Address 7315 Frontage Road, #110
City/State/Zip Shawnee Mission, KS 66204
Contact Person William P. Moore, III
Phone 913-384-2234

NE SW SW Sec. 29. Twp. 17. S, Rg 22..... West
**1,055 Ft. from South Line of Section
**4,235 Ft. from East Line of Section

(Note: Locate well on Section Plat on reverse side)

CONTRACTOR: License # 6142
Name Town Oil Company
City/State Paola, KS

Nearest lease or unit boundary line 270..... feet
County Miami.....
Lease Name Feebeck #1 * Well # 305**
Ground surface elevation 950..... feet MSL

Well Drilled For: Well Class: Type Equipment:
Oil SWD X Infield X Mud Rotary
Gas X Inj Pool Ext Air Rotary
OWWO Expl Wildcat Cable

Domestic well within 330 feet: ___ yes X no
Municipal well within one mile: ___ yes X no
Surface pipe by Alternate: 1 2x
Depth to bottom of fresh water 45.....
Depth to bottom of usable water 200.....
Surface pipe planned to be set 20.....
Projected Total Depth 500..... feet
Formation Wayside

If OWWO: old well info as follows:
Operator
Well Name
Comp Date Old Total Depth.....

I certify that well will comply with K.S.A. 55-101, et seq., plus eventually plugging hole to KCC specifications. *Was 990 N., Was
cementing will be done immediately upon setting production casing. 3,975' W, Was #306
Date Signature of Operator or Agent Title President

For KCC Use:

Conductor Pipe Required feet; Minimum Surface Pipe Required feet per Alt. 1 2


This Authorization Expires 4-2-86 Approved By 10-2-85

Must be filed with the K.C.C. five (5) days prior to commencing well
 This card void if drilling not started within six (6) months of date received by K.C.C.

Important procedures to follow:

1. Notify District office before setting surface casing.
2. Set surface casing by circulating cement to the top.
3. File completion forms ACO-1 with K.C.C. within 90 days of well completion, following instructions on ACO-1, side 1, and including copies of wireline logs.
4. Notify District office 48 hours prior to old well workover or re-entry.
5. Prior to filing Intent, prepare a proposed plugging plan in case well is D & A, then obtain approval of plan when calling district office prior to setting surface pipe.
6. Submit plugging report (CP-4) to K.C.C. after plugging is completed.
7. Obtain an approved injection docket number before disposing of salt water.
8. Notify K.C.C. within 10 days when injection commences or terminates.
9. If an alternate 2 completion, cement in the production pipe from below any usable water to surface within 120 days of spud date.

A Regular Section of Land
1 Mile = 5,280 Ft.

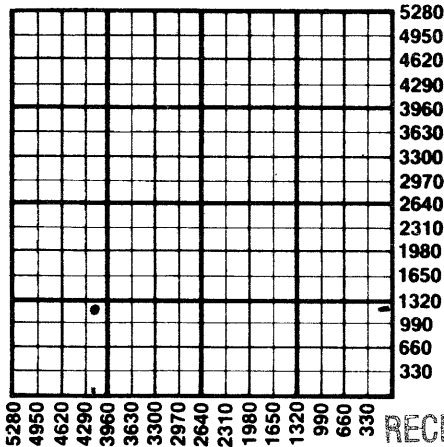

RECEIVED
 STATE CORPORATION COMMISSION

OCT 24 1985

CONSERVATION DIVISION
 Wichita, Kansas

State Corporation Commission of Kansas
 Conservation Division
 200 Colorado Derby Building
 Wichita, Kansas 67202
 (316) 263-3238