

CARD MUST BE TYPED

State of Kansas

CARD MUST BE SIGNED

### NOTICE OF INTENTION TO DRILL

(see rules on reverse side)

Expected Spud Date..... 7      5      1988  
   month      day      year

API Number 15-121-26, 925-00-00

SA

OPERATOR: License # ..... 6142  
Name ..... TOWN OIL COMPANY  
Address ..... RR #4  
City/State/Zip ..... Paola, Kansas 66071  
Contact Person ..... Lester Town  
Phone ..... (913) 294-2125

SW NE NE ..... Sec. 23      Twp. 17      S, Rg. 22       East  
4455 .....      \_\_\_\_\_ West  
1155 .....      \_\_\_\_\_ Ft. from South Line of Section  
   \_\_\_\_\_ Ft. from East Line of Section

(Note: Locate well on Section Plat on reverse side)

CONTRACTOR: License # .....  
Name ..... COMPAMY TOOLS  
City/State .....

Nearest lease or unit boundary line ..... 825 ..... feet  
County ..... MIAMI

Well Drilled For:      Well Class:      Type Equipment:  
 Oil      \_\_\_\_\_ Storage       Infield      \_\_\_\_\_ Mud Rotary  
\_\_\_\_\_ Gas      \_\_\_\_\_ Inj      \_\_\_\_\_ Pool Ext.       Air Rotary  
\_\_\_\_\_ OWWO      \_\_\_\_\_ Expl      \_\_\_\_\_ Wildcat      \_\_\_\_\_ Cable

Lease Name ..... ROHRER      Well # ..... 4

Ground surface elevation ..... feet MSL

Domestic well within 330 feet:      \_\_\_\_\_ yes       no

Municipal well within one mile:      \_\_\_\_\_ yes       no

Depth to bottom of fresh water ..... 30 .....

Depth to bottom of usable water ..... 200 .....

Surface pipe by Alternate:      \_\_\_\_\_ 1       2

Surface pipe planned to be set ..... 20 .....

Conductor pipe required ..... None .....

Projected Total Depth ..... 700 ..... feet

Formation ..... Bartlesville .....

If OWWO: old well info as follows:

Operator .....  
Well Name .....  
Comp Date .....      Old Total Depth .....

I certify that well will comply with K.S.A. 55-101, et seq., plus eventually plugging hole to KCC specifications.

Date ..... 6-30-88 ..... Signature of Operator or Agent *Shank* ..... Agent

For KCC Use:

Conductor Pipe Required ..... feet; Minimum Surface Pipe Required ..... 20 ..... feet per Alt. **X(2)**


This Authorization Expires 12-30-88 ..... Approved By PEH 6-30-88 .....

EFFECTIVE DATE: 7-5-88

Must be filed with the K.C.C. five (5) days prior to commencing well  
 This card void if drilling not started within six (6) months of date received by K.C.C.

**Important procedures to follow:**

**A Regular Section of Land  
 1 Mile = 5,280 Ft.**

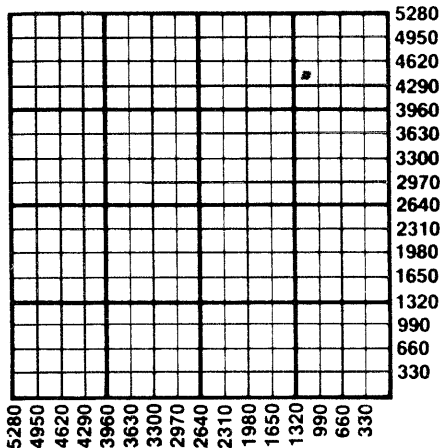

1. Notify District office before setting surface casing.
2. Set surface casing by circulating cement to the top.
3. File completion forms ACO-1 with K.C.C. within 120 days of well spud date, following instructions on ACO-1, side 1, and including copies of wireline logs.
4. Notify District office 48 hours prior to old well workover or re-entry.
5. Prior to filing Intent, prepare a proposed plugging plan in case well is D & A, then obtain approval of plan when calling district office prior to setting surface pipe.
6. Submit plugging reports (CPM) to K.C.C. after plugging is completed.
7. Obtain an approved injection docket number before disposing of salt water.
8. Notify K.C.C. within 10 days when injection commences or terminates.
9. If an alternate 2 completion, cement in the production pipe from below any usable water to surface within 120 days of spud date.

RECEIVED  
 JUN 30 1988  
 06-30-88  
 CONSERVATION DIVISION  
 Wichita, Kansas

State Corporation Commission of Kansas  
 Conservation Division  
 200 Colorado Derby Building  
 Wichita, Kansas 67202-1212  
 (316) 263-3238