

15-163-20887-00-00


STATE OF KANSAS
STATE CORPORATION COMMISSION

WELL PLUGGING RECORD

Give All Information Completely
Make Required Affidavit
Mail or Deliver Report to
Conservation Division
State Corporation Comm.
245 North Water
Wichita, KS 67202

Rooks County. Sec. 22 Twp. 8 Rge. 77 W
Location as "NE/CNW $\frac{1}{4}$ SW $\frac{1}{4}$ " or footage from lines NE-NE-SE

Lease Owner Pawl Ruggels
Lease Name Larsen "A" Well No. #1
Office Address P.O. Box 254 Natoma, KS 67651
Character of Well (Completed as Oil, Gas or Dry Hole) D+H

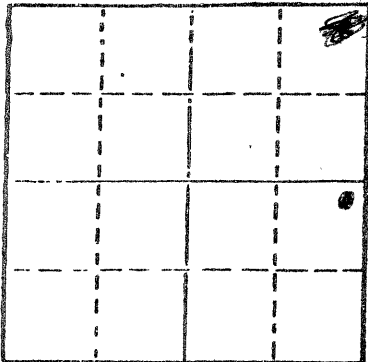

Locate well correctly on above
Section Plat

Date Well completed 1-21 1979
Application for plugging filed 2-2 1979
Application for plugging approved 2-2 1979
Plugging commenced 2-2 1979
Plugging completed 2-3 1979

Reason for abandonment of well or producing formation Dry Hole
If a producing well is abandoned, date of last production 19

Was permission obtained from the Conservation Division or its agents before plugging was commenced? Yes
Leo Massey

Name of Conservation Agent who supervised plugging of this well
Producing formation None Depth to top _____ Bottom _____ Total Depth of Well 3147
Show depth and thickness of all water, oil and gas formations.

216' of 8 5/8 surface casing

OIL, GAS OR WATER RECORDS

CASING RECORD

FORMATION	CONTENT	FROM	TO	SIZE	PUT IN	PULLED OUT

Describe in detail the manner in which the well was plugged, indicating where the mud fluid was placed and the method or methods used in introducing it into the hold. If cement or other plugs were used, state the character of same and depth placed, from _____ feet to _____ feet for each plug set.
all cement 50/50 pos mix 290 gal
Filled hole with heavy mud to 660' mix 50 sacks &
and pumped through drill pipe.
Filled hole to 200' mixed 25 sacks cement and
pumped through drill pipe.
Filled hole to 40' pushed plug down mixed 10
sacks cement and pumped in hole to bot dom
of celer.

5 Sacks cement in Rat Hole

RECEIVED
MAR 26 1979
CONSERVATION DIVISION
Wichita, Kansas


(If additional description is necessary, use BACK of this sheet)
Name of Plugging Contractor Lambanco Drilling Co.

STATE OF Kansas COUNTY OF Osborne, ss. 3-26-79
Homer B. Chesney (employee of owner) or (owner or operator)

of the above-described well, being first duly sworn on oath, says: That I have knowledge of the facts, statements, and matters herein contained and the log of the above-described well as filed and that the same are true and correct. So help me God.

(Signature) Homer B Chesney
Natoma, Kansas 67651 (Address)

SUBSCRIBED AND SWORN TO before me this 23rd day of March, 1979

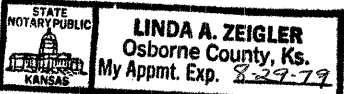

My commission expires 8-29-79
Linda A. Zeigler Notary Public.