

15-163-20833-00-00


STATE OF KANSAS
STATE CORPORATION COMMISSION

WELL PLUGGING RECORD

Give All Information Completely
Make Required Affidavit
Mail or Deliver Report to
Conservation Division
State Corporation Comm.
245 North Water
Wichita, KS 67202

Rooks County, Sec. 20 Twp. 8S Rge. 17 E/W
Location as "NE/CNW 1/4 SW 1/4" or footage from lines

C W/2 NE SW
Lease Owner Jack Reeder
Lease Name Reeder Well No. #1
Office Address Star Route Box 1202 Tehachaki, Calif. 93561
Character of Well (Completed as Oil, Gas or Dry Hole) dry hole

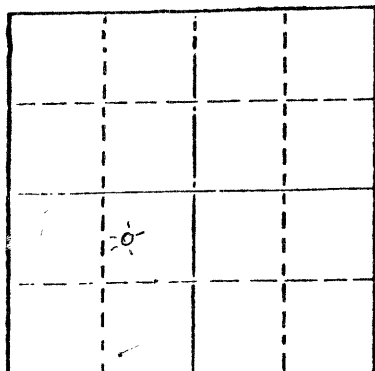

Locate well correctly on above Section Plat

Date Well completed September 2, 1978
Application for plugging filed September 2, 1978
Application for plugging approved September 2, 1978
Plugging commenced September 2, 8:20 A.M. 1978
Plugging completed September 2, 12:30 P.M. 1978
Reason for abandonment of well or producing formation no commercial production

If a producing well is abandoned, date of last production 19

Was permission obtained from the Conservation Division or its agents before plugging was commenced? yes

Name of Conservation Agent who supervised plugging of this well Leo Massey

Producing formation Depth to top Bottom Total Depth of Well

Show depth and thickness of all water, oil and gas formations.

OIL, GAS OR WATER RECORDS

CASING RECORD

FORMATION	CONTENT	FROM	TO	SIZE	PUT IN	PULLED OUT
	surface casing	0	208'	8 5/8"	208'	0

Describe in detail the manner in which the well was plugged, indicating where the mud fluid was placed and the method or methods used in introducing it into the hold. If cement or other plugs were used, state the character of same and depth placed, from feet to feet for each plug set.

50 sxs @ 500'
25 sxs @ 215'
15 sxs Hull and 10 sxs @ 50oz

RECEIVED
STATE CORPORATION COMMISSION
SEP 07 1978
CONSERVATION DIVISION
Wichita, Kansas

9-7-78

(If additional description is necessary, use BACK of this sheet)


Name of Plugging Contractor Pioneer Drilling Company, Inc.
308 West Mill Plainville, Kansas 67663

STATE OF Kansas COUNTY OF Rooks, ss.
Charles G. Comeau (employee of owner) or (owner or operator)
of the above-described well, being first duly sworn on oath, says: That I have knowledge of the facts, statements, and matters herein contained and the log of the above-described well as filed and that the same are true and correct. So help me God.

(Signature) [Signature]
308 West Mill Plainville, Kansas 67663
(Address)

SUBSCRIBED AND SWORN TO before me this 6th day of September, 1978

My commission expires

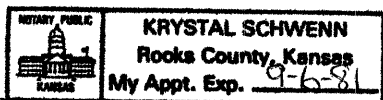

[Signature]
Notary Public.

W E L L L O G

OPERATOR: Jack Reeder

15-163-20835-00-00

WELL NAME: Reeder #1

LOCATION: C W/2 NE SW Sec. 20-8-17W

COUNTY: Rooks

STATE: Kansas

WELL COMMENCED: August 23, 1978

WELL COMPLETED: September 2, 1978

ELEVATION: 1898' KB

TOTAL DEPTH: 3367'

PRODUCTION: dry hole

RIG NO: #1

CASING - 8-5/8": 208' of 28# cemented with 130 sxs common 2% gel and 3% cc

5-1/2": none

ALL MEASUREMENTS TAKEN FROM THE TOP OF ROTARY BUSHING:

FROM	TO	FORMATION	DEVIATION FROM VERTICAL	REMARKS:
0'	216'		180'-	1/4 degree
216'	1233'	shale and sand		
1233'	1254'	Anhydrite		
1254'	1263'	Anhydrite		
1263'	1840'	shale and sand		
1840'	2130'	shale and lime	2115'-	1 degree
2130'	2343'	shale		
2343'	2535'	lime and shale		
2535'	2806'	lime and shale		
2806'	2953'	shale and lime		
2953'	3018'	lime and shale	2990'-	1/2 degree
3018'	3022'	lime		
3022'	3055'	shale and lime		
3055'	3110'	lime		
3110'	3140'	lime		
3140'	3150'	shale and lime		
3150'	3162'	lime		
3162'	3196'	lime and shale		
3196'	3230'	shale and lime		
3230'	3265'	lime and shale		
3265'	3320'	lime and shale		
3320'	3323'	Arbuckle		
3323'	3327'			
3327'	3336'	lime		
3336'	3367'	Arbuckle		

RECEIVED
STATE GEOLOGICAL COMMISSION
SEP 07 1978
CONSERVATION DIVISION
Topeka, Kansas
9-7-78

STATE OF KANSAS
COUNTY OF

The undersigned hereby certifies that to the best of his knowledge and belief, the above facts are true and correct

PIONEER DRILLING CO., INC.

By Charles Green

SUBSCRIBED AND SWORN TO, BEFORE ME, This 6th day of Sept., 1978.

MY COMM. EXP. SEPT. 6, 1981.

Krystal Schwenn
KRYSTAL SCHWENN - NOTARY PUBLIC

