

15-163-20920-00-00


STATE OF KANSAS
STATE CORPORATION COMMISSION

WELL PLUGGING RECORD

Give All Information Completely
Make Required Affidavit
Mail or Deliver Report to
Conservation Division
State Corporation Comm.
245 North Water
Wichita, KS 67202

Rooks County, Sec. 23 Twp. 8 Rge. 17W E/W
Location as "NE/CNW¹/SW¹" or footage from lines S1/2 S1/2 SE

Lease Owner Chesney Oil Co.
Lease Name Harrison Well No. #4
Office Address Box # 254 Natoma, Kansas 67651
Character of Well (Completed as Oil, Gas or Dry Hole) D&A

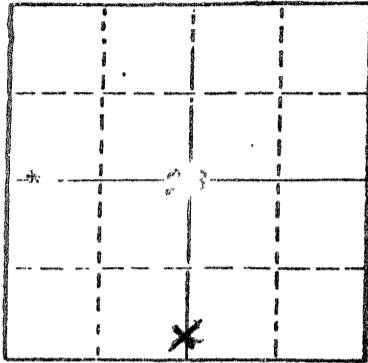

Locate well correctly on above
Section Plat

Date Well completed 5-21- 1979
Application for plugging filed 9-13 1979
Application for plugging approved 19
Plugging commenced 5-21- 1979
Plugging completed 5-21- 1979

Reason for abandonment of well or producing formation Dry Hole
If a producing well is abandoned, date of last production 19

Was permission obtained from the Conservation Division or
its agents before plugging was commenced? Yes

Name of Conservation Agent who supervised plugging of this well Leo Massey
Producing formation Depth to top Bottom Total Depth of Well 3430
Show depth and thickness of all water, oil and gas formations.

OIL, GAS OR WATER RECORDS

CASING RECORD

FORMATION	CONTENT	FROM	TO	SIZE	PUT IN	PULLED OUT

Describe in detail the manner in which the well was plugged, indicating where the mud fluid was placed and the method or methods used in introducing it into the hold. If cement or other plugs were used, state the character of same and depth placed, from feet to feet for each plug set. All cement 50-50 poz mix 2% gel
Filled hole with heavy mud to 580 ft. Mixed 60 sacks and pumped in hole through drill pipe. Filled hole to 210 ft. Mixed 25 sacks and pumped through drill pipe. Filled hole to 40ft. mixed 10sacks cement pushed plug down and ~~plug~~ pumped in hole to bottom of cellar.
5 sacks cement in rat hole.

RECEIVED
STATE CORPORATION COMMISSION

SEP 17 1979

(If additional description is necessary, use BACK of this sheet)
Name of Plugging Contractor Lawbanco Drilling Inc. 9-17-79
Conservation Division
Wichita, Kansas

STATE OF Kansas COUNTY OF Osborne, ss.
Homer B. Chesney (employee of owner) or (owner or operator)
of the above-described well, being first duly sworn on oath, says: That I have knowledge of the facts, statements, and matters herein contained and the log of the above-described well as filed and that the same are true and correct. So help me God.

(Signature) Homer B. Chesney
Natoma, Kas.
(Address)

SUBSCRIBED AND SWORN TO before me this 13th day of September, 1979

Linda A. Zeigler
Linda A. Zeigler Notary Public.

My commission expires 8-29-83

