

CARD MUST BE TYPED

State of Kansas

CARD MUST BE SIGNED

CORRECTED COPY

NOTICE OF INTENTION TO DRILL

(see rules on reverse side)

CORRECTION

11-8-85

Starting Date 9 .. 2 .. 1985 ..
month day year

API Number 15— 121-26,648-00-00

X East

* OPERATOR: License # * 7496

S. W. ... 1/4 Sec. 20.. Twp. 17.. S, Rg2-2..... West

Name * Robert Welk Johnson

..... 660..... Ft. from South Line of Section

Address Box 253

..... 446.0..... Ft. from East Line of Section

City/State/Zip Osawatimie Kansas 66064

(Note: Locate well on Section Plat on reverse side)

Contact Person Paul Jackson

Phone 913 795 2586

CONTRACTOR: License # 6157

Nearest lease or unit boundary line 66.0..... feet

Name J and J Oil Company

County..... Miami.....

City/State Mound City Kansas 66056

Lease Name.. Brown..... Well #... E-3.....

Well Drilled For: Well Class: Type Equipment:

Ground surface elevation N/A..... feet MSL

Oil SWD X Infield X Mud Rotary

Domestic well within 330 feet: _____ yes _____ X no

Gas X Inj Pool Ext. Air Rotary

Municipal well within one mile: _____ yes _____ X no

OWWO Expl Wildcat Cable

Surface pipe by Alternate: 1 _____ 2X _____

If OWWO: old well info as follows:

Depth to bottom of fresh water..... 620.....

Operator

Depth to bottom of usable water 21.....

Well Name

Surface pipe planned to be set

Comp Date Old Total Depth.....

Projected Total Depth 520..... feet

I certify that well will comply with K.S.A. 55-101, et seq., plus eventually plugging hole to KCC specifications.

Formation.....

Date 8-21-85 Signature of Operator or Agent Paul Jackson Title... Contractor.....

For KCC Use:

Conductor Pipe Required feet; Minimum Surface Pipe Required feet per Alt. 1 2


This Authorization Expires 2-26-86 Approved By 8-26-85

Must be filed with the K.C.C. five (5) days prior to commencing well
This card void if drilling not started within six (6) months of date received by K.C.C.

Important procedures to follow:

1. Notify District office before setting surface casing.
2. Set surface casing by circulating cement to the top.
3. File completion forms ACO-1 with K.C.C. within 90 days of well completion, following instructions on ACO-1, side 1, and including copies of wireline logs.
4. Notify District office 48 hours prior to old well workover or re-entry.
5. Prior to filing Intent, prepare a proposed plugging plan in case well is D & A, then obtain approval of plan when calling district office prior to setting surface pipe.
6. Submit plugging report (CP-4) to K.C.C. after plugging is completed.
7. Obtain an approved injection docket number before disposing of salt water.
8. Notify K.C.C. within 10 days when injection commences or terminates.

A Regular Section of Land
1 Mile = 5,280 Ft.

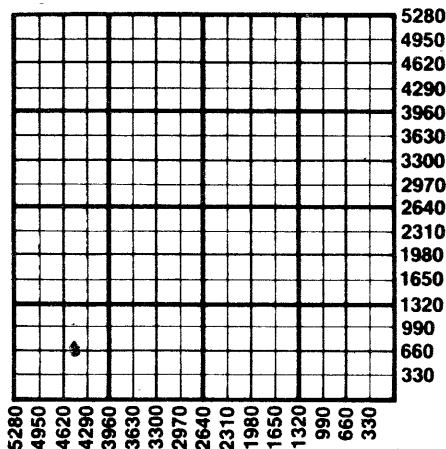

RECEIVED
STATE CORPORATION COMMISSION

NOV 6 1960

CONSERVATION DIVISION
Wichita, Kansas

9. If an alternate 2 completion, cement in the production pipe from any usable water to surface within 120 days of spud date.

State Corporation Commission of Kansas
Conservation Division
200 Colorado Derby Building
Wichita, Kansas 67202
(316) 263-3238