

CARD MUST BE TYPED

State of Kansas

CARD MUST BE SIGNED

NOTICE OF INTENTION TO DRILL

(see rules on reverse side)

CORRECTION  
11-8-85

CORRECTED COPY

Starting Date 9 2 1985  
month day year

API Number 15- 121-26646 100-00  
X East

OPERATOR: License # \* 7496

S. W. 1/4 Sec. 20.. Twp. 17.. S, Rg. 22... West

Name \* Robert Welk Johnson

49.5 Ft. from South Line of Section

Address Box 253

46.20 Ft. from East Line of Section

City/State/Zip Osawatomie Kansas 66064

(Note: Locate well on Section Plat on reverse side)

Contact Person Paul Jackson

Phone 913 795 2586

Nearest lease or unit boundary line 49.5 feet

CONTRACTOR: License # 6157

County Miami

Name J and J Oil Company

Lease Name Brown Well # D-2

City/State Mound City Kansas 66056

Ground surface elevation N/A feet MSL

Well Drilled For: Well Class: Type Equipment:

Domestic well within 330 feet: yes X no

X Oil SWD X Infield X Mud Rotary

Municipal well within one mile: yes X no

Gas Inj Pool Ext Air Rotary

Surface pipe by Alternate: 1 2X

OWWO Expl Wildcat Cable

If OWWO: old well info as follows:

Depth to bottom of fresh water 6.2

Operator

Depth to bottom of usable water 2.00

Well Name

Surface pipe planned to be set 2.1

Comp Date Old Total Depth

Projected Total Depth 5.00 feet

Formation Peru

I certify that well will comply with K.S.A. 55-101, et seq., plus eventually plugging hole to KCC specifications.

\_\_\_\_\_

Date 8-21-85 Signature of Operator or Agent Paul Jackson Title Contractor

Ford J Oil Co  
#7992

For KCC Use:

Conductor Pipe Required 2-26-86 feet; Minimum Surface Pipe Required 8-26-85 feet per Alt. 1 2


This Authorization Expires Approved By

Must be filed with the K.C.C. five (5) days prior to commencing well  
 This card void if drilling not started within six (6) months of date received by K.C.C.

**Important procedures to follow:**

1. Notify District office before setting surface casing.
2. Set surface casing by circulating cement to the top.
3. File completion forms ACO-1 with K.C.C. within 90 days of well completion, following instructions on ACO-1, side 1, and including copies of wireline logs.
4. Notify District office 48 hours prior to old well workover or re-entry.
5. Prior to filing Intent, prepare a proposed plugging plan in case well is D & A, then obtain approval of plan when calling district office prior to setting surface pipe.
6. Submit plugging report (CP-4) to K.C.C. after plugging is completed.
7. Obtain an approved injection docket number before disposing of salt water.
8. Notify K.C.C. within 10 days when injection commences or terminates.
9. If an alternate 2 completion, cement in the production pipe from below any usable water to surface within 120 days of spud date.

**A Regular Section of Land  
 1 Mile = 5,280 Ft.**

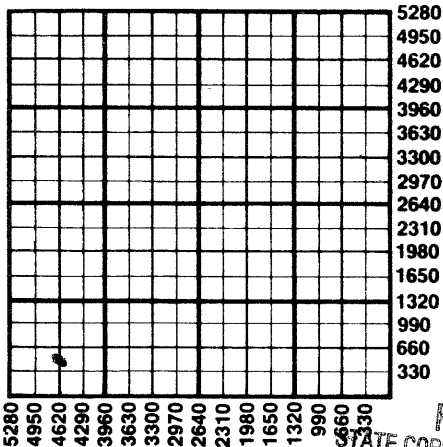

RECEIVED  
 STATE CORPORATION COMMISSION  
 11-06-85  
 NOV 6

CONSERVATION DIVISION  
 Wichita, Kansas

State Corporation Commission of Kansas  
 Conservation Division  
 200 Colorado Derby Building  
 Wichita, Kansas 67202  
 (316) 263-3238