

CARD MUST BE TYPED

CORRECTED COPY

State of Kansas

NOTICE OF INTENTION TO DRILL

(see rules on reverse side)

CARD MUST BE SIGNED

CORRECTION

11-8-85

Starting Date 9.2.1985
month day year

API Number 15— 121-26645-00-00

OPERATOR: License # * 7496

Name * Robert Welk Johnson

Address Box 253

City/State/Zip Osawatimie Kansas 66064

Contact Person Paul Jackson

Phone 913.795.2586

CONTRACTOR: License # 6157

Name J. and J. Oil Company

City/State Mound City Kansas 66056

Well Drilled For: Well Class: Type Equipment:

☒ Oil ☐ SWD ☒ Infield ☒ Mud Rotary☐ Gas ☐ Inj ☐ Pool Ext. ☐ Air Rotary☐ OWWO ☐ Expl ☐ Wildcat ☐ Cable

If OWWO: old well info as follows:

Operator

Well Name

Comp Date Old Total Depth

I certify that well will comply with K.S.A. 55-101, et seq., plus eventually plugging hole to KCC specifications.

Date 8-21-85 Signature of Operator or Agent Title Contractor

For KCC Use:

Conductor Pipe Required feet; Minimum Surface Pipe Required feet per Alt. 1 2

This Authorization Expires 2-26-86 Approved By 8-26-85

S. ... W. ... 1/4. Sec. 20 ... Twp. 17 ... S, Rg. 22 ... ☒ East

..... 49.5 Ft. from South Line of Section

..... 49.5 Ft. from East Line of Section

(Note: Locate well on Section Plat on reverse side)

Nearest lease or unit boundary line 330 feet

County Miami

Lease Name Brown Well # D-1

Ground surface elevation N/A feet MSL

Domestic well within 330 feet: ☐ yes ☒ noMunicipal well within one mile: ☐ yes ☒ noSurface pipe by Alternate: 1 ☐ 2 ☒

Depth to bottom of fresh water 6.2

Depth to bottom of usable water 20.0

Surface pipe planned to be set 2.1

Projected Total Depth 50.0 feet

Formation Peru


Kerry Ford Oil Co. # 7992

Must be filed with the K.C.C. five (5) days prior to commencing well
This card void if drilling not started within six (6) months of date received by K.C.C.

Important procedures to follow:

1. Notify District office before setting surface casing.
2. Set surface casing by circulating cement to the top.
3. File completion forms ACO-1 with K.C.C. within 90 days of well completion, following instructions on ACO-1, side 1, and including copies of wireline logs.
4. Notify District office 48 hours prior to old well workover or re-entry.
5. Prior to filing Intent, prepare a proposed plugging plan in case well is D & A, then obtain approval of plan when calling district office prior to setting surface pipe.
6. Submit plugging report (CP-4) to K. C. C. after plugging is completed.
7. Obtain an approved injection docket number before disposing of salt water.
8. Notify K.C.C. within 10 days when injection commences or terminates.

A Regular Section of Land
1 Mile = 5,280 Ft.

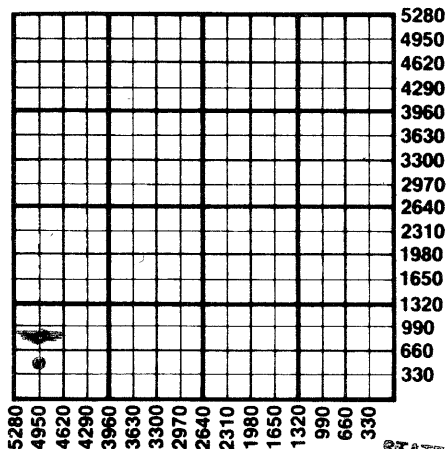

RECEIVED
STATE CORPORATION COMMISSION

NOV 6 1985

CONSERVATION DIVISION
Wichita, Kansas

If an alternate 2 completion, cement in the production pipe from below any usable water to surface within 120 days of spud date.

State Corporation Commission of Kansas
Conservation Division
200 Colorado Derby Building
Wichita, Kansas 67202
(316) 263-3238