

CARD MUST BE TYPED

State of Kansas

CARD MUST BE SIGNED

NOTICE OF INTENTION TO DRILL

(see rules on reverse side)

✓

Starting Date 6 17 1988
month day year

OPERATOR: License # 4648

Name Four J. Oil Company

Address Box 253

City/State/Zip Osawatomie, Kansas 66064

Contact Person Paul Jackson

Phone 913 795 2586

CONTRACTOR: License # 6157

Name J & J Oil Company

City/State Mound City Kansas 66056

Well Drilled For:	Well Class:	Type Equipment:
<input checked="" type="checkbox"/> Oil	<input checked="" type="checkbox"/> Infield	<input checked="" type="checkbox"/> Mud Rotary
<input type="checkbox"/> Gas	<input type="checkbox"/> Pool Ext.	<input type="checkbox"/> Air Rotary
<input type="checkbox"/> OWWO	<input type="checkbox"/> Wildcat	<input type="checkbox"/> Cable
<input type="checkbox"/> SWD		
<input type="checkbox"/> Inj		
<input type="checkbox"/> Expl		

If OWWO: old well info as follows:

Operator

Well Name

Comp Date Old Total Depth

I certify that well will comply with K.S.A. 55-101, et seq., plus eventually plugging hole to KCC specifications.
 _____ cementing will be done immediately upon setting production casing.
 Date 6 - 7 - 88 Signature of Operator or Agent Paul Jackson Title Partner

For KCC Use:
 Conductor Pipe Required feet; Minimum Surface Pipe Required 20 feet per Alt. 2
 This Authorization Expires 12-10-88 Approved By Doc 6-10-88

API Number 15- 121-26,917 - 00 - 00 X East
5/2 N/2 S/2 SW
8 W. 1 S. Sec. 20 Twp. 17 S. Rg. 22 West
825 Ft. from South Line of Section
3960 Ft. from East Line of Section

(Note: Locate well on Section Plat on reverse side)

Nearest lease or unit boundary line 495 feet
 County Miami
 Lease Name Brown Well # F - 6
 Ground surface elevation N/A feet MSL
 Domestic well within 330 feet: yes no
 Municipal well within one mile: yes no
 Surface pipe by Alternate: 1 2
 Depth to bottom of fresh water 62'
 Depth to bottom of usable water 200'
 Surface pipe planned to be set 21'
 Projected Total Depth 500' feet
 Formation Peru


EFFECTIVE DATE: 6-15-88

Must be filed with the K.C.C. five (5) days prior to commencing well
 This card void if drilling not started within six (6) months of date received by K.C.C.

Important procedures to follow:

1. Notify District office before setting surface casing.
2. Set surface casing by circulating cement to the top.
3. File completion forms ACO-1 with K.C.C. within 90 days of well completion, following instructions on ACO-1, side 1, and including copies of wireline logs.
4. Notify District office 48 hours prior to old well workover or re-entry.
5. Prior to filing Intent, prepare a proposed plugging plan in case well is D & A, then obtain approval of plan when calling district office prior to setting surface pipe.
6. Submit plugging report (CP-4) to K.C.C. after plugging is completed.
7. Obtain an approved injection docket number before disposing of salt water.
8. Notify K.C.C. within 10 days when injection commences or terminates.
9. If an alternate 2 completion, cement in the production pipe from below any usable water to surface within 120 days of spud date.

**A Regular Section of Land
 1 Mile = 5,280 Ft.**

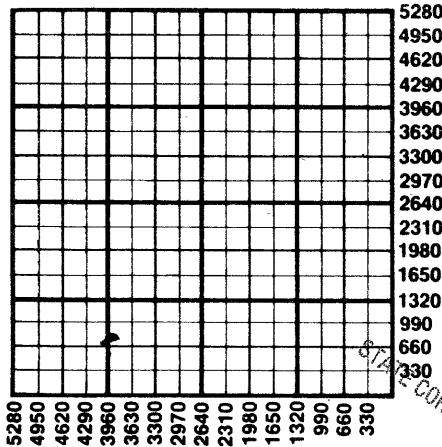

RECEIVED
 STATE CORPORATION COMMISSION
 JUN 10 1988
 CONSERVATION DIVISION
 Wichita, Kans

State Corporation Commission of Kansas
 Conservation Division
 200 Colorado Derby Building
 Wichita, Kansas 67202
 (316) 263-3238