

CARD MUST BE TYPED

State of Kansas

CARD MUST BE SIGNED

CORRECTED COPY

NOTICE OF INTENTION TO DRILL

(see rules on reverse side)

corrected
11-8-85

Starting Date 9 2 1985
month day year

API Number 15- 121-26,649-00-00

East

S. W. 1/4 Sec. 20 Twp. 17 S, Rg. 22

825 Ft. from South Line of Section

4620 Ft. from East Line of Section

(Note: Locate well on Section Plat on reverse side)

OPERATOR: License # *7496

Name * Robert Welk Johnson

Address Box 253

City/State/Zip Osawatomie Kansas 66064

Contact Person Paul Jackson

Phone 913 795 2586

CONTRACTOR: License # 6157

Name J and J Oil Company

City/State Mound City, Kansas 66056

Nearest lease or unit boundary line 660 feet

County Miami

Lease Name Brown Well # F-2

Ground surface elevation N/A feet MSL

Domestic well within 330 feet: yes no

Municipal well within one mile: yes no

Surface pipe by Alternate: 1 2

Depth to bottom of fresh water 62

Depth to bottom of usable water 200

Surface pipe planned to be set 21

Projected Total Depth 500 feet

Formation Peru

Well Drilled For: Well Class: Type Equipment:

Oil SWD Infield Mud Rotary

Gas Inj Pool Ext. Air Rotary

OWWO Expl Wildcat Cable

If OWWO: old well info as follows:

Operator

Well Name

Comp Date Old Total Depth

I certify that well will comply with K.S.A. 55-101, et seq., plus eventually plugging hole to KCC specifications.

Date 8-21-85 Signature of Operator or Agent Paul Jackson Title Contractor

James Ford Oil Co #7992

For KCC Use:

Conductor Pipe Required feet; Minimum Surface Pipe Required feet per Alt. 1 2


This Authorization Expires 2-26-86 Approved By 8-26-85

Must be filed with the K.C.C. five (5) days prior to commencing well
 This card void if drilling not started within six (6) months of date received by K.C.C.

Important procedures to follow:

1. Notify District office before setting surface casing.
2. Set surface casing by circulating cement to the top.
3. File completion forms ACO-1 with K.C.C. within 90 days of well completion, following instructions on ACO-1, side 1, and including copies of wireline logs.
4. Notify District office 48 hours prior to old well workover or re-entry.
5. Prior to filing Intent, prepare a proposed plugging plan in case well is D & A, then obtain approval of plan when calling district office prior to setting surface pipe.
6. Submit plugging report (CP-4) to K.C.C. after plugging is completed.
7. Obtain an approved injection docket number before disposing of salt water.
8. Notify K.C.C. within 10 days when injection commences or terminates.
9. If an alternate 2 completion, cement in the production pipe from below any usable water to surface within 120 days of spud date.

A Regular Section of Land
 1 Mile = 5,280 Ft.

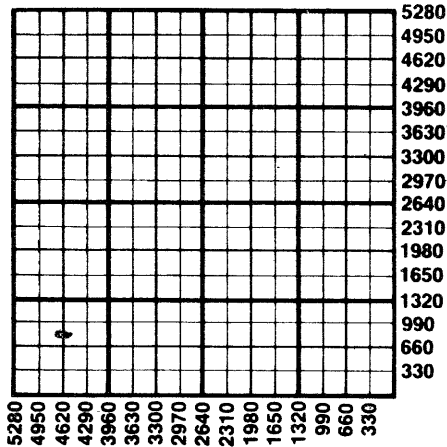

RECEIVED
 STATE CORPORATION COMMISSION
 11-06-85
 NOV 6 1985

CONSERVATION DIVISION
 Wichita, Kansas

State Corporation Commission of Kansas
 Conservation Division
 200 Colorado Derby Building
 Wichita, Kansas 67202
 (316) 263-3238