

(AMENDED INTENT)
CARD MUST BE TYPED

State of Kansas
NOTICE OF INTENTION TO DRILL
(see rules on reverse side)

CORRECTION
CARD MUST BE SIGNED
10-5-84

Starting Date: ...Sept...21...1984.....
month day year

API Number 15- 059-23,719 -00-00

OPERATOR: License # 5682.....
Name Hughes Drilling Company.....
Address 122 North Main.....
City/State/Zip Wellsville, Kansas 66092..
Contact Person Roger A. Hughes.....
Phone 1-913-883-2235.....

SE $\frac{1}{4}$ NE $\frac{1}{4}$... Sec .33 Twp .15 S, Rge .21 East
(location) West

CONTRACTOR: License # 5682 Rig 305.....
Name Hughes Drilling Co.....
City/State Wellsville, Kansas.....

3515..... Ft North from Southeast Corner of Section
*1055..... Ft West from Southeast Corner of Section
(Note: Locate well on Section Plat on reverse side)

Well Drilled For: Well Class: Type Equipment:
 Oil Swd Infield Mud Rotary
 Gas Inj Pool Ext. Air Rotary
 OWWO Expl Wildcat Cable

Nearest lease or unit boundary line1055..... feet.
County Franklin.....
Lease Name Murphy..... Well# 20.....
Domestic well within 330 feet: yes no
Municipal well within one mile: yes no

If OWWO: old well info as follows:

Operator
Well Name
Comp Date Old Total Depth
Projected Total Depth 700..... feet
Projected Formation at TD #1 SQUIRREL.....
Expected Producing Formations #1 SQUIRREL.....

Depth to Bottom of fresh water30..... feet
Lowest usable water formation
Depth to Bottom of usable water200..... feet
Surface pipe by Alternate: 1 2
Surface pipe to be set20..... feet
Conductor pipe if any required feet
Ground surface elevation1000..... feet MSL
This Authorization Expires 3-10-85
Approved By 9-10-84

I certify that we will comply with K.S.A. 55-101, et seq., plus eventually plugging hole to K.C.C. specifications. *Was 3515' N from SE corner

Date 10-2-84..... Signature of Operator or Agent Beatrice E. Hughes Title Secretary.....
197' W from SE corner of sec.


Must be filed with the K.C.C. five (5) days prior to commencing well
 This card void if drilling not started within six (6) months of date received by K.C.C.

10-4-84

STATE OF KANSAS
 RECEIVED
 OCT 04 1984
 CONSERVATION DIVISION
 WICHITA, KANSAS

Important procedures to follow:

**A Regular Section of Land
 1 Mile = 5,280 Ft.**

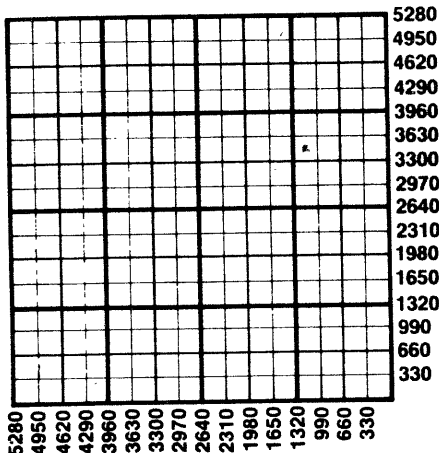

1. Notify District office before setting surface casing.
2. Set surface casing by circulating cement to the top.
3. File completion forms ACO-1 with K.C.C. within 90 days of well completion, following instructions on ACO-1, side 1, and including copies of wireline logs.
4. Notify District office 48 hours prior to old well workover or re-entry.
5. Prior to plugging, prepare a plugging plan, then obtain agreement from the appropriate district office for an approved plugging plan.
6. Submit plugging report (CP-4) to K.C.C. after plugging is completed.
7. Obtain an approved injection docket number before disposing of salt water.
8. Notify K.C.C. within 10 days when injection commences or terminates.
9. If an alternate 2 completion, cement in the production pipe from below any usable water to surface within 120 days of spud date.

3515' N from SE corner of Sec.
 1055' W from SE corner of Sec.

**State Corporation Commission of Kansas
 Conservation Division
 200 Colorado Derby Building
 Wichita, Kansas 67202
 (316)263-3238**