


STATE OF KANSAS
STATE CORPORATION COMMISSION

Give All Information Completely
Make Required Affidavit
Mail or Deliver Report to:
Conservation Division
State Corporation Commission
800 Bittling Building
Wichita, Kansas

WELL PLUGGING RECORD

NORTH

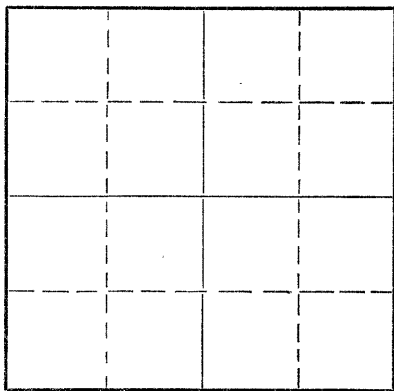

Locate well correctly on above
Section Plat

Sheridan County. Sec. 30 Twp. 7S Rge. 26W (E) W (W)
Location as "NE/CNW/SW" or footage from lines SW SW SW
Lease Owner Anschutz Drilling Company, Inc.
Lease Name Phillips & Marshall Well No. 1
Office Address 709 Union Nat'l Bk Bldg., Wichita, Kansas
Character of Well (completed as Oil, Gas or Dry Hole) Dry Hole
Date well completed 8-18-1952
Application for plugging filed 8-18-1952
Application for plugging approved 8-18-1952
Plugging commenced 8-18-1952
Plugging completed 8-18-1952
Reason for abandonment of well or producing formation Dry

If a producing well is abandoned, date of last production _____ 19____
Was permission obtained from the Conservation Division or its agents before plugging was commenced? Yes

Name of Conservation Agent who supervised plugging of this well Eldon Petty
Producing formation _____ Depth to top _____ Bottom _____ Total Depth of Well 4515 Feet
Show depth and thickness of all water, oil and gas formations.

OIL, GAS OR WATER RECORDS

CASING RECORD

| FORMATION | CONTENT | FROM | TO | SIZE | PUT IN | PULLED OUT |
|-----------|---------|------|----|--------|--------|------------|
| | | | | 8-5/8" | 221' | |
| | | | | | | |
| | | | | | | |
Describe in detail the manner in which the well was plugged, indicating where the mud fluid was placed and the method or methods used in introducing it into the hole. If cement or other plugs were used, state the character of same and depth placed, from _____ feet to _____ feet for each plug set.

Top plug set at 40' with 10 sacks cement
Bottom plug set at 210' with 15 sacks cement

RECEIVED
STATE CORPORATION COMMISSION
AUG 27 1952
AUG 27 1952
CONSERVATION DIVISION
Wichita, Kansas

(If additional description is necessary, use BACK of this sheet)
Name of Plugging Contractor Anschutz Drilling Company, Inc.
Address 709 Union Nat'l Bk Bldg., Wichita, Kansas

STATE OF KANSAS, COUNTY OF SEDGWICK, ss.
Leon L. Mehler (employee of owner) or (owner or operator) of the above-described well, being first duly sworn on oath, says: That I have knowledge of the facts, statements, and matters herein contained and the log of the above-described well as filed and that the same are true and correct. So help me God.

(Signature) Leon L. Mehler
709 Union Nat'l Bk Bldg., Wichita, Ks.
(Address)

SUBSCRIBED AND SWORN TO before me this 26th day of August, 19 52

My commission expires May 2, 1956
Jacqueline Linn Notary Public.

PLUGGING
FILE SEC 30 T 7 R 26 W
BOOK PAGE 39 LINE 9

DRILLER'S LOG

ANSCHUTZ DRILLING COMPANY, INC.
 #1 Phillips & Marshall
 SW SW SW - 30-7S-26W
 Sheridan County, Kansas

| FROM | TO | |
|------|------|----------------------|
| 0 | 200 | Sand |
| 200 | 230 | Shale |
| 230 | 550 | Shale & sand |
| 550 | 900 | Shale, sand & shells |
| 900 | 1450 | Shale & sand streaks |
| 1450 | 1770 | Shale, shells & sand |
| 1770 | 1870 | Sandy shale & shells |
| 1870 | 2060 | Sand |
| 2060 | 2321 | Shale & red bed |
| 2321 | 2355 | Anhydrite |
| 2355 | 2445 | Shale & shells |
| 2445 | 2705 | Shale & lime |
| 2705 | 2865 | Shale & shells |
| 2865 | 3560 | Shale & lime |
| 3560 | 3740 | Lime |
| 3740 | 3843 | Lime & shale |
| 3843 | 4075 | Lime |
| 4075 | 4109 | Shale |
| 4109 | 4406 | Lime & shale |
| 4406 | 4425 | Shale, lime & sand |
| 4425 | 4466 | Lime & shale |
| 4466 | 4515 | Lime & chert |
| | 4515 | TOTAL DEPTH |
| | | D&A |

COMMENCED: 8-3-52
 COMPLETED: 8-18-52

CASING RECORD
 Set 8-5/8" surface casing at 221 feet
 with 175 sacks cement.

ELEVATION: 2637 RB

TOPS
 Anhydrite 2321
 Heebner 3804
 Toronto 3832
 Lansing 3847
 B/KC 4075
 Weathered Mississippian 4401
 Solid Mississippian Lime 4412

STATE OF KANSAS)
) SS
 COUNTY OF SEDGWICK)

I hereby affirm that the foregoing is a true and correct copy of the log of Anschutz Drilling Company, Inc. #1 Phillips & Marshall, located SW SW SW of Section 30-7S-26W, Sheridan County, Kansas.

ANSCHUTZ DRILLING COMPANY, INC.

BY: *Leon L. Mehler*
 Leon L. Mehler

Subscribed and sworn to before me this 25th day of August, 1952.

Jacqueline L. Linn
 Notary Public

My commission expires: May 2, 1956

PLUGGING
 FILE 30-7-26W
 BOOK 39 9

RECEIVED
 CORPORATION COMMISSION
 AUG 27 1952
 AUG 27 1952
 CONSERVATION DIVISION
 Wichita, Kansas