


STATE OF KANSAS  
STATE CORPORATION COMMISSION

WELL PLUGGING RECORD

Give All Information Completely  
Make Required Affidavit  
Mail or Deliver Report to:  
Conservation Division  
State Corporation Commission  
212 No. Market  
Wichita, Kansas

Sheridan County, Sec. 31 Twp. 7S Rge. 26 (E) W (W)

Location as "NE/CNW/SW" or footage from lines SE SE NE  
Lease Owner Murfin Drilling Co  
Lease Name Schwarzenberger Well No. 1  
Office Address 617 Union Center Bldg, Wichita, Kansas  
Character of Well (completed as Oil, Gas or Dry Hole) Dry Hole  
Date well completed 1-4 1969  
Application for plugging filed 19  
Application for plugging approved 19  
Plugging commenced 1-4 1969  
Plugging completed 1-4 1969  
Reason for abandonment of well or producing formation Dry hole

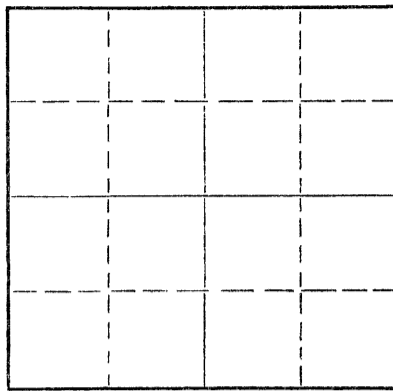

Locate well correctly on above Section Plat

If a producing well is abandoned, date of last production 19  
Was permission obtained from the Conservation Division or its agents before plugging was commenced? yes

Name of Conservation Agent who supervised plugging of this well Bill Nichols  
Producing formation \_\_\_\_\_ Depth to top \_\_\_\_\_ Bottom \_\_\_\_\_ Total Depth of Well 4034 Feet  
Show depth and thickness of all water, oil and gas formations.

OIL, GAS OR WATER RECORDS

CASING RECORD

FORMATION	CONTENT	FROM	TO	SIZE	PUT IN	PULLED OUT
		0	220	7"	216	

Describe in detail the manner in which the well was plugged, indicating where the mud fluid was placed and the method or methods used in introducing it into the hole. If cement or other plugs were used, state the character of same and depth placed, from \_\_\_\_\_ feet to \_\_\_\_\_ feet for each plug set.

- # 1 Plug @ 1150' W/65 sacks cement
- # 2 Plug @ 245' W/15 sacks cement
- # 3 Plug @ 40' W/10 sacks cement

RECEIVED  
STATE CORPORATION COMMISSION  
JAN 10 1969  
CONSERVATION DIVISION  
Wichita, Kansas  
JAN 10, 1969

(If additional description is necessary, use BACK of this sheet)  
Name of Plugging Contractor Halliburton Co  
Address Hill City, Kansas

STATE OF Kansas, COUNTY OF Graham, ss.  
Louis Edgett (employee of owner) or (owner or operator) of the above-described well, being first duly sworn on oath, says: That I have knowledge of the facts, statements, and matters herein contained and the log of the above-described well as filed and that the same are true and correct. So help me God.

(Signature) Louis Edgett  
Louis Edgett, Bookkeeper  
P. O. Box D, Hill City, Kansas  
(Address)

SUBSCRIBED AND SWORN TO before me this 9th day of January, 1969  
Cora Jesler  
Notary Public.

My commission expires January 20, 1972



CONTRACTOR'S WELL LOG

COMPANY: MURFIN DRILLING CO  
 CONTRACTOR: PAINE DRILLING CO., INC.  
 WELL: SCHWARZENBERGER # 1  
 LOCATION: SE SE NE Sec. 31-7S-26W  
 SHERIDAN COUNTY, KANSAS  
 COMMENCED: DECEMBER 19, 1968  
 COMPLETED: JANUARY 4, 1969

0	220	Surface Soils & Sands
220	2247	Sand & Shale
2247	2282	Anhydrite
2282	3261	Shale & Sand
3261	3655	Shale & Lime
3655	3970	Lime
3970	4034	Lime & Shale

RECEIVED  
 STATE CORPORATION COMMISSION  
 JAN 10 1969  
 CONSERVATION DIVISION  
 Wichita, Kansas

SET 7" SURFACE PIPE AT 220' WITH 125 SACKS CEMENT

DRY AND ABANDONED

WE HEREBY CERTIFY THAT THE ABOVE IS A CORRECT AND ACCURATE LOG OF THE ABOVE MENTIONED WELL, AS SHOWN ON THE DAILY DRILLING REPORTS.

PAINE DRILLING CO., INC.

BY: Louis Edgett  
 LOUIS EDGETT, BOOKKEEPER

SUBSCRIBED AND SWORN TO BEFORE ME THIS 9th DAY OF JANUARY, 1969.

Cora Taylor  
 NOTARY PUBLIC

My Commission Expires January 20, 1972