


15-179-00062-00-00

STATE OF KANSAS  
STATE CORPORATION COMMISSION

Give All Information Completely  
Make Required Affidavit  
Mail or Deliver Report to:  
Conservation Division  
State Corporation Commission  
211 No. Broadway  
Wichita, Kansas

WELL PLUGGING RECORD

Sheridan County. Sec. 22 Twp. 7S Rge. 26W (#) (W)  
Location as "NE/CNW/SW" or footage from lines NW 1/4 NW 1/4 NE 1/4  
Lease Owner Leben Drilling, Inc.  
Lease Name "C" Jones Well No. 1  
Office Address 905 Central Bldg., Wichita, Kans.  
Character of Well (completed as Oil, Gas or Dry Hole) Dry Hole  
Date well completed 5-29-58 19  
Application for plugging filed 5-29-58 19  
Application for plugging approved 5-29-58 19  
Plugging commenced 5-29-58 19  
Plugging completed 5-29-58 19  
Reason for abandonment of well or producing formation Dry Hole

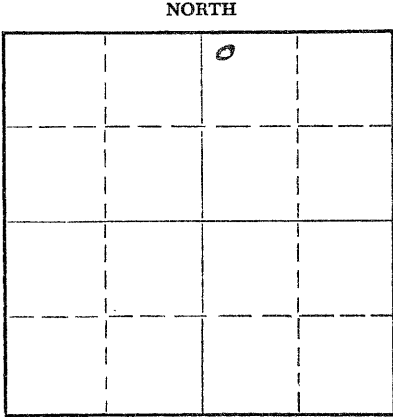

Locate well correctly on above  
Section Plat

If a producing well is abandoned, date of last production - 19  
Was permission obtained from the Conservation Division or its agents before plugging was commenced? yes

Name of Conservation Agent who supervised plugging of this well Fabricius  
Producing formation \_\_\_\_\_ Depth to top \_\_\_\_\_ Bottom \_\_\_\_\_ Total Depth of Well 4080 Feet  
Show depth and thickness of all water, oil and gas formations.

OIL, GAS OR WATER RECORDS

CASING RECORD

FORMATION	CONTENT	FROM	TO	SIZE	PUT IN	PULLED OUT
				8 5/8"	233'	

Describe in detail the manner in which the well was plugged, indicating where the mud fluid was placed and the method or methods used in introducing it into the hole. If cement or other plugs were used, state the character of same and depth placed, from \_\_\_\_\_ feet to \_\_\_\_\_ feet for each plug set.

1st plug @ 550' w/25 sacks cement  
2nd plug @ 230' w/15 sacks cement  
Top plug @ 40' w/10 sacks cement

(If additional description is necessary, use BACK of this sheet)

Name of Plugging Contractor Leben Drilling, Inc.  
Address same

STATE OF Kansas, COUNTY OF Ka Sedgwick, ss.  
I, Frank Hamlin (employee of owner) or (owner or operator) of the above-described well, being first duly sworn on oath, says: That I have knowledge of the facts, statements, and matters herein contained and the log of the above-described well as filed and that the same are true and correct. So help me God.

(Signature) Frank Hamlin  
905 Central Bldg., Wichita, Kansas  
(Address)

SUBSCRIBED AND SWORN TO before me this 30th day of May, 1958

My commission expires June 17, 1961  
Ruth N. Benjamin Notary Public.



STATE OF KANSAS  
JUN 7 1958  
FILE SEC 22 7 R26W  
BOOK PAGE 105 LINE 3  
PLUGGING

DRILLER'S LOG

COMPANY: LEDEN DRILLING, INC.  
 CONTRACTOR: LEDEN DRILLING, INC.  
 FARM: C. JONES #1  
 LOCATION: 1/4 1/4 1/4 SEC. 22-7S-20W  
 SHERIDAN COUNTY, KANSAS  
 COMMENCED: Surface Hole 3-12-58; Under Surface 3-21-58.  
 COMPLETED: 5-23-58

0	310	Sand and Shale		
310	1150	Shale & Shells		
1150	1250	Sand	TOPS:	
1250	1350	Sand & Shale	Anhydrite	2325
1350	1575	Shale & Shells	Reobner	2525
1575	1797	Shale & Lime Sls.	Toronto	2545
1797	1800	Shale	Lansing-K.C.	2665
1800	2105	Shale & Sand	Os. K.C.	2675
2105	2325	Bedded & Shale		
2325	2360	Anhydrite		
2360	2465	Shale & Shells	Elevation	2525 D.F.
2465	2515	Lime & Shale		2525 K.D.
2515	2800	Shale & Shells		
2800	3105	Shale & Lime		
3105	3305	Lime & Shale		
3305	3521	Lime & Shale		
3521	3524	Reobner		
3524	3555	Lime & Shale		
3555	4000	Lime		
	4000	Lime		
		<u>Rotary Total Depth - D &amp; A</u>		

Set 233' of 8 5/8" surface casing with 115 sacks cement.

I, Frank Hamlin, do hereby certify that the above and foregoing is a true and correct copy of the log of the C. Jones #1, located 1/4 1/4 1/4 Section 22, Township 7 South, Range 25 West, Sheridan County, Kansas, as reflected by the files of Leden Drilling, Inc.

LEDEN DRILLING, INC.

By: Frank Hamlin  
 Frank Hamlin

STATE OF KANSAS )  
 ) SS:  
 COUNTY OF SEDGWICK )

Subscribed and sworn to before me, a Notary Public, in and for Sedgwick County, Kansas, this 4th day of June, 1958.

Paul H. Bergman  
 Paul H. Bergman, Notary Public

My Commission Expires:  
 June 17, 1961

FILED  
 JUN 7 1958

JUN 7 1958

PLUGGING  
 FILE - REV 22 T 7 R 260  
 BOOK - PAGE 105 LINE 3