

STATE OF KANSAS
STATE CORPORATION COMMISSION


Form CP-4

RP

Give All Information Completely
Make Required Affidavit
Mail or Deliver Report to:
Conservation Division
State Corporation Commission
211 No. Broadway
Wichita, Kansas

WELL PLUGGING RECORD

NORTH

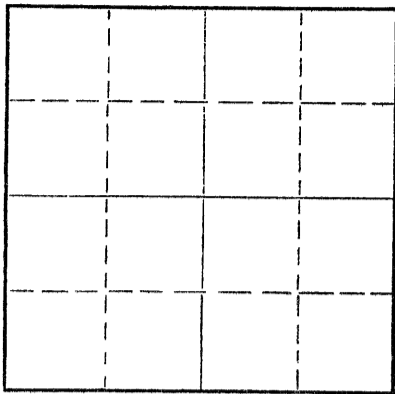

Locate well correctly on above
Section Plat

Sheridan County. Sec. 24 Twp. 7S Rge. 26W (W)
Location as "NE/CNW/SW" or footage from lines C SE SE
Lease Owner Theodore Gore
Lease Name Barnett Well No. 1
Office Address 640 - 4th Nat'l Bldg., Wichita, Kansas
Character of Well (completed as Oil, Gas or Dry Hole) Dry Hole
Date well completed 8-18-67 19
Application for plugging filed 8-18-67 19
Application for plugging approved 8-18-67 19
Plugging commenced 8-18-67 19
Plugging completed 8-18-67 19
Reason for abandonment of well or producing formation Dry Hole

If a producing well is abandoned, date of last production 19
Was permission obtained from the Conservation Division or its agents before plugging was commenced? yes

Name of Conservation Agent who supervised plugging of this well W. L. Nichols
Producing formation _____ Depth to top _____ Bottom _____ Total Depth of Well 3980 Feet
Show depth and thickness of all water, oil and gas formations.

OIL, GAS OR WATER RECORDS

CASING RECORD

FORMATION	CONTENT	FROM	TO	SIZE	PUT IN	PULLED OUT
				8 5/8"	267'	none

Describe in detail the manner in which the well was plugged, indicating where the mud fluid was placed and the method or methods used in introducing it into the hole. If cement or other plugs were used, state the character of same and depth placed, from _____ feet to _____ feet for each plug set.

Spotted 100 sks. cement @ 2020'
Spotted 20 sks. cement @ 270'
Plug @ 40' w/10 sks. cement

RECEIVED
STATE CORPORATION COMMISSION

AUG 22 1967
AUG 22, 1967
CONSERVATION DIVISION
Wichita, Kansas

(If additional description is necessary, use BACK of this sheet)

Name of Plugging Contractor Leben Drilling, Inc.
Address Box 486, Great Bend, Kansas 67530

STATE OF KANSAS, COUNTY OF BARTON, ss.
Leslie Kite

(employee of owner) or (owner or operator) of the above-described well, being first duly sworn on oath, says: That I have knowledge of the facts, statements, and matters herein contained and the log of the above-described well as filed and that the same are true and correct. So help me God.

(Signature) Leslie Kite
Box 486, Great Bend, Kansas 67530
(Address)

SUBSCRIBED AND SWORN TO before me this 21st day of August, 1967.

My commission expires April 1, 1971

Ulanda Nichols
Notary Public.

DRILLER'S LOG

COMPANY:
CONTRACTOR:
FARM:
LOCATION:

COMMENCED:
COMPLETED:

Empire Drilling Company
LEBEN DRILLING, INC.
BARNETT #1
C SE SE SECTION 24-7S-26W
SHERIDAN COUNTY, KANSAS
8-9-67
8-18-67

RECEIVED
CONSERVATION DIVISION
AUG 22 1967
AUG 22, 1967
CONSERVATION DIVISION
Wichita, Kansas

0	238	Sand
238	267	Blue Shale
267	1220	Shale
1220	1410	Shale, Sand
1410	1475	Shale, Shells
1475	1827	Shale, Lime
1827	2005	Redbed
2005	2039	Shale, Lime
2039	2045	Shale
2045	2217	Shale, Shells
2217	2251	Anhydrite
2251	2830	Shale
2830	3560	Shale, Lime
3560	3980	Lime
	<u>3980</u>	<u>RTD - D. & A.</u>

8 5/8" 8 rd. thd. used surface casing Set @ 267' cemented with 200 sacks Common, 2% cc

I, Leslie Kite, do hereby certify that the above and foregoing is a true and correct copy of the log of the Barnett #1 Well, located C SE SE of Section 24, Township 7 South, Range 26 West, Sheridan County, Kansas, as reflected by the records of Leben Drilling, Inc.

Leslie Kite

Leslie Kite

STATE OF KANSAS)
) SS
COUNTY OF BARTON)

Subscribed and sworn to and before me, a Notary Public, in and for Barton County, Kansas, this 21st day of August, 1967.

Ulanda Nichols

Ulanda Nichols

My Commission Expires:
April 1, 1971