


STATE OF KANSAS  
STATE CORPORATION COMMISSION

Form CP-4

Give All Information Completely  
Make Required Affidavit  
Mail or Deliver Report to:  
Conservation Division  
State Corporation Commission  
212 No. Market  
Wichita, Kansas

WELL PLUGGING RECORD

NORTH

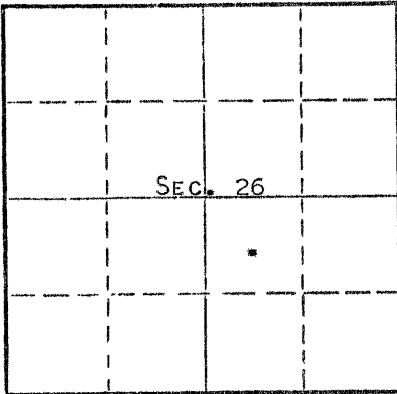

Locate well correctly on above  
Section Plat

SHERIDAN County. Sec. 26 Twp. 7S Rge 27W (E) (W)  
Location as "NE/CNWxSWx" or footage from lines. C NW SE  
Lease Owner PETROLEUM, INC.  
Lease Name CRESSLER 'B' Well No. 1  
Office Address ROUTE 2, GREAT BEND, KANSAS  
Character of Well (completed as Oil, Gas or Dry Hole) DRY HOLE  
Date well completed SEPTEMBER 3 19 67  
Application for plugging filed SEPTEMBER 3 19 67  
Application for plugging approved SEPTEMBER 3 19 67  
Plugging commenced SEPTEMBER 3 19 67  
Plugging completed SEPTEMBER 3 19 67  
Reason for abandonment of well or producing formation NO PRODUCIBLE ZONE

If a producing well is abandoned, date of last production. NONE 19  
Was permission obtained from the Conservation Division or its agents before plugging was commenced? YES

Name of Conservation Agent who supervised plugging of this well W. L. NICHOLS  
Producing formation \_\_\_\_\_ Depth to top \_\_\_\_\_ Bottom \_\_\_\_\_ Total Depth of Well 4121' Feet  
Show depth and thickness of all water, oil and gas formations.

OIL, GAS OR WATER RECORDS

CASING RECORD

FORMATION	CONTENT	FROM	TO	SIZE	PUT IN	PULLED OUT
				8-5/8"	254'	NONE

Describe in detail the manner in which the well was plugged, indicating where the mud fluid was placed and the method or methods used in introducing it into the hole. If cement or other plugs were used, state the character of same and depth placed, from \_\_\_\_\_ feet to \_\_\_\_\_ feet for each plug set.

MUD TO 890', FOLLOWED BY 100 SACKS CEMENT, FROM 310' TO 265'  
USED 15 SACKS CEMENT. (FARMER WILL USE WELL FOR WATER WELL.  
FARMER AGREED WITH STATE CORPORATION COMMISSION TO TAKE  
RESPONSIBILITY OF WELL)

RECEIVED  
SEP 15 1967  
SEP 15 1967  
CONSERVATION DIVISION  
Wichita, Kansas

(If additional description is necessary, use BACK of this sheet)  
Name of Plugging Contractor GARVEY DRLG. CO.  
Address ROUTE #2, GREAT BEND, KANSAS

STATE OF KANSAS, COUNTY OF BARTON, ss.  
MONTE CHADD (employee of owner) or (owner or operator) of the above-described well, being first duly sworn on oath, says: That I have knowledge of the facts, statements, and matters herein contained and the log of the above-described well as filed and that the same are true and correct. So help me God. MONTE CHADD DIST. PROD. SUPT.

(Signature) *Monte Chadd*  
ROUTE 2, GREAT BEND, KANSAS  
(Address)

SUBSCRIBED AND SWORN to before me this 14 day of SEPTEMBER, 19 67

My commission expires APRIL 14, 1971

*Arthur J. Miles*  
Notary Public.

# WELL LOG

COMPANY Petroleum, Inc.

SEC. 26 T. 7S R. 27W

FARM Cressler

NO. B-1

LOC. NW SE


TOTAL DEPTH 4121'

COUNTY Sheridan

COMM. 8-28-67

COMP. 9-3-67

CONTRACTOR Garvey Drilling Company

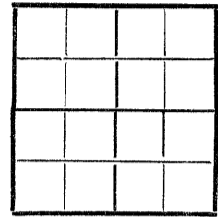

CASING 8 5/8" @ 280' w/250 sx

ELEVATION 2680 K.B.

PRODUCTION D & A

FIGURES INDICATE BOTTOM OF FORMATIONS

- 240' Sand
- 265' Shale
- 280' Blue Shale
- 820' Shale
- 849' Sand and Shale
- 1215' Shale
- 1300' Shale and Shells
- 1400' Sand
- 1840' Shale and Shells
- 1885' Anhydrite
- 1990' Shale
- 2160' Sand
- 2386' Shale
- 2415' Anhydrite
- 2625' Shale
- 2855' Red Bed and Shale
- 2900' Shale
- 3095' Shale and Lime
- 3120' Shale
- 3285' Shale with Lime
- 3668' Lime with Shale
- 3935' Shale and Lime
- 4121' Lime with Shale
- 4121' RTD

**RECEIVED**  
STATE CORPORATION COMMISSION

SEP 15 1967  
SEP 15 1967  
CONSERVATION DIVISION  
Wichita, Kansas

State of Kansas

County of Barton } ss

I, Sam N. Stephens of Garvey Drilling Company

upon oath state the above and foregoing is a true and correct copy of the log of the Cressler B-1 well.

*Sam N. Stephens*

Subscribed and sworn to before me this 12th day of September 19 67

My Commission Expires: November 5th, 1969

*Richard S. Deys*  
NOTARY PUBLIC