

STATE OF KANSAS
STATE CORPORATION COMMISSION

Form CP-4


Give All Information Completely
Make Required Affidavit
Mail or Deliver Report to:
Conservation Division
State Corporation Commission
212 No. Market
Wichita, Kansas

WELL PLUGGING RECORD

Sheridan County. Sec. 35 Twp. 7S Rge. (E) 26 (W)

Location as "NE/CNW%SW%" or footage from lines SE NW
Lease Owner Burch Exploration, Inc.
Lease Name SCHEETZ Well No. 1
Office Address 601 Union Center, Wichita, Kansas
Character of Well (completed as Oil, Gas or Dry Hole) Dry Hole
Date well completed July 10, 19 67
Application for plugging filed (Verbally) July 10, 19 67
Application for plugging approved (Verbally) July 10, 19 67
Plugging commenced July 10, 19 67
Plugging completed July 10, 19 67
Reason for abandonment of well or producing formation Dry Hole

NORTH

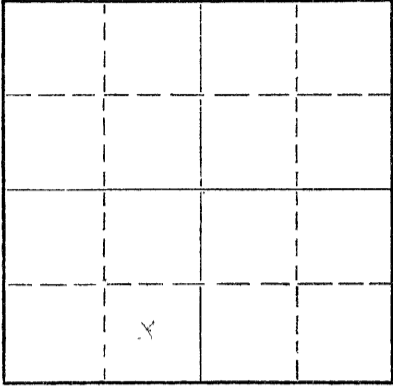

Locate well correctly on above
Section Plat

If a producing well is abandoned, date of last production 19
Was permission obtained from the Conservation Division or its agents before plugging was commenced? Yes

Name of Conservation Agent who supervised plugging of this well Bill Nichols
Producing formation Depth to top Bottom Total Depth of Well 3980 Feet
Show depth and thickness of all water, oil and gas formations.

OIL, GAS OR WATER RECORDS

CASING RECORD

| FORMATION | CONTENT | FROM | TO | SIZE | PUT IN | PULLED OUT |
|-----------|---------|------|----|------|--------|------------|
| | | | | 7" | 253' | None |
| | | | | | | |
| | | | | | | |
| | | | | | | |
| | | | | | | |
| | | | | | | |
| | | | | | | |
| | | | | | | |
| | | | | | | |

Describe in detail the manner in which the well was plugged, indicating where the mud fluid was placed and the method or methods used in introducing it into the hole. If cement or other plugs were used, state the character of same and depth placed, from feet to feet for each plug set.

Plugged with a pump truck. First plug was from 1015' back to 700' with 50 sx. of cement; second plug at 240' with 15 sx. of cement. The top plug was set at 40' plugged back to surface with 8 sx. of cement. Job was completed at 8:30 p.m., July 10, 1967.

RECEIVED
STATE CORPORATION COMMISSION
JUL 18 1967
JUL 18 1967
CONSERVATION DIVISION
Wichita, Kansas

(If additional description is necessary, use BACK of this sheet)

Name of Plugging Contractor Abercrombie Drilling, Inc.
Address 801 Union Center; Wichita, Kansas

STATE OF KANSAS, COUNTY OF SEDGWICK, ss.
A. L. Abercrombie (employed by owner) or (owner or operator) of the above-described

well, being first duly sworn on oath, says: That I have knowledge of the facts, statements, and matters herein contained and the log of the above-described well as filed and that the same are true and correct. So help me God.

(Signature) A. L. Abercrombie
801 Union Center; Wichita, Kansas
(Address)

SUBSCRIBED AND SWORN to before me this 17th day of July, 19 67

My commission expires March 31, 1970

Margie De Montgomery
Margie De Montgomery
Notary Public.

CONTRACTOR'S WELL LOG

COMPANY: Burch Exploration, Inc.
 CONTRACTOR: Abercrombie Drilling, Inc.
 FARM: SCHEETZ #1
 LOCATION: SE NW, Sec. 35-7S-26W
 Sheridan County, Kansas
 COMMENCED: July 4, 1967
 COMPLETED: July 10, 1967

| | | |
|------|------|-----------------------|
| 0 | 800 | Shale |
| 800 | 1581 | Shale, Shells, & Sand |
| 1581 | 1823 | Shale & Red Bed |
| 1823 | 2008 | Shale & Shells |
| 2008 | 2241 | Anhydrite |
| 2241 | 2650 | Shale |
| 2650 | 3845 | Lime & Shale |
| 3845 | 3960 | Lime |
| 3960 | 3980 | Shale |
| | 3980 | Rotary Total Depth |

Set 7" casing at 253' with 125 sacks of Sunset cement.
 Dry and Abandoned.

| ELECTRIC LOG TOPS: | | ELEVATION: |
|--------------------|--------------|------------|
| Topeka | 3492 (- 950) | 2542 K. B. |
| Heebner | 3704 (-1162) | 2541 D. F. |
| Toronto | 3728 (-1186) | 2535 G. L. |
| Lansing | 3745 (-1203) | |
| B/K. C. | 3961 (-1419) | |

STATE OF KANSAS)
) SS
 COUNTY OF SEDGWICK)

I, A. L. Abercrombie, do hereby certify that the above and foregoing is a true and correct copy of the log of the SCHEETZ #1, SE NW, Section 35-7S-26W, Sheridan County, Kansas, as reflected by the files of Abercrombie Drilling, Inc.


A. L. Abercrombie
 A. L. Abercrombie

Subscribed and sworn to before me, a Notary Public, in and for Sedgwick County, Kansas, this 17th day of July, 1967.

Margo Dee Montgomery
 Margo Dee Montgomery
 Notary Public

My Commission Expires:

March 31, 1970

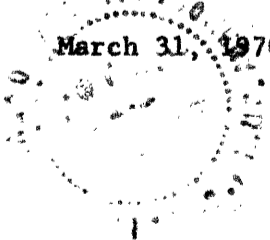

RECEIVED
 STATE CORPORATION COMMISSION

JUL 18 1967
 JUL 18, 1967
 CONSERVATION DIVISION
 Wichita, Kansas