

STATE OF KANSAS
STATE CORPORATION COMMISSION

WELL PLUGGING RECORD

OR

FORMATION PLUGGING RECORD

Strike out upper line when reporting plugging off formations.

Give All Information Completely
Make Required Affidavit
Mail or Deliver Report to:
Conservation Division
State Corporation Commission
800 Bittling Building
Wichita, Kansas

Sheridan County, Sec. 35 Twp. 7S Rge. 26W (E) (W)

Location as "NE 1/4 NW 1/4 SW 1/4" or footage from lines SW 1/4 SW 1/4 SE 1/4

Lease Owner Continental Oil Co.

Lease Name Crowfoot Well No. 1

Office Address Ponca City, Kansas

Character of Well (completed as Oil, Gas or Dry Hole) Stratigraphic Test

Date well completed Nov. 3, 1943

Application for plugging filed Nov. 3, 1943

Application for plugging approved Nov. 3, 1943


Plugging commenced Nov. 3, 1943

Plugging completed Nov. 4, 1943

Reason for abandonment of well or producing formation Stratigraphic Test

If a producing well is abandoned, date of last production 19

Was permission obtained from the Conservation Division or its agents before plugging was commenced? Yes

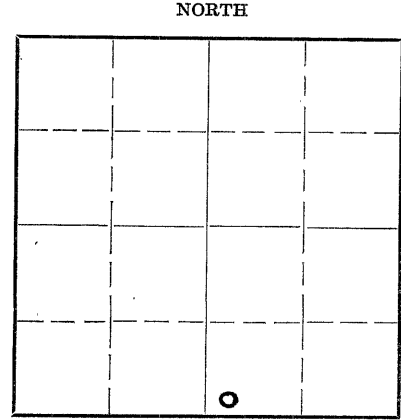

Locate well correctly on above Section Plat

Name of Conservation Agent who supervised plugging of this well C. T. Alexander

Producing formation Depth to top Bottom Total Depth of Well Feet

Show depth and thickness of all water, oil and gas formations.


OIL, GAS OR WATER RECORDS

CASING RECORD

Formation	Content	From	To	Size	Put In	Pulled Out
				8 5/8"	175 ft.	none

Describe in detail the manner in which the well was plugged, indicating where the mud fluid was placed and the method or methods used in introducing it into the hold. If cement or other plugs were used, state the character of same and depth placed, from feet to feet for each plug set.

The hole was full of heavy mud. A bridge was set at 300 feet and cemented with 23 sacks of cement thru the drill pipe. The hole was then filled with mud to 26 feet where another plug was set and the hole filled to the top with cement.

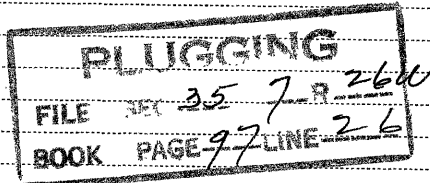

(If additional description is necessary, use BACK of this sheet)


Correspondence regarding this well should be addressed to J. George Klein
Address Box 471 Norton, Kansas

STATE OF Kansas, COUNTY OF Rooks, ss.
J. George Klein (employee of owner) or (owner or operator) of the above-described well, being first duly sworn on oath, says: That I have knowledge of the facts, statements, and matters herein contained and the log of the above-described well as filed and that the same are true and correct. So help me God.

(Signature) J. George Klein
Norton, Kansas
George Klein

SUBSCRIBED AND SWORN to before me this 12th day of November

My commission expires March 6, 1944

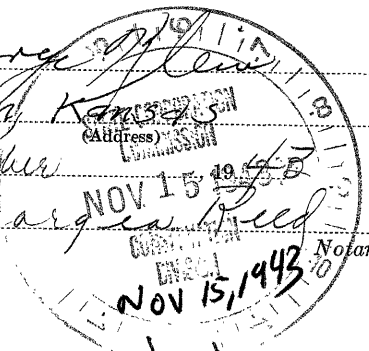

11/15/43