

STATE OF KANSAS  
STATE CORPORATION COMMISSION


Give All Information Completely  
Make Required Affidavit  
Mail or Deliver Report to:  
Conservation Division  
State Corporation Commission  
211 No. Broadway  
Wichita, Kansas

WELL PLUGGING RECORD

Sheridan County, Sec. 6 Twp. 7S Rge. 27 (E) (W) X

Location as "NE/CNW%SW%" or footage from lines SW SW SW  
Lease Owner Empire Drilling Company  
Lease Name Selbe Well No. 1  
Office Address 650 Fourth National Bank Building, Wichita, Kansas  
Character of Well (completed as Oil, Gas or Dry Hole) Dry Hole  
Date well completed November 28, 1959 19  
Application for plugging filed November 28, 1959 19  
Application for plugging approved November 28, 1959 19  
Plugging commenced November 28, 1959 19  
Plugging completed November 28, 1959 19  
Reason for abandonment of well or producing formation Dry Hole

NORTH

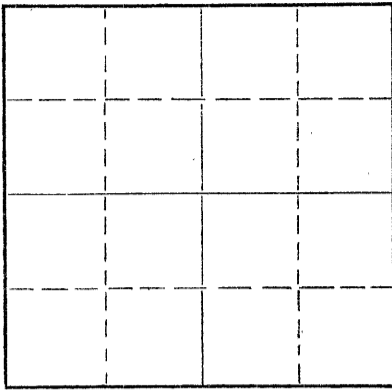

Locate well correctly on above Section Plat

If a producing well is abandoned, date of last production 19  
Was permission obtained from the Conservation Division or its agents before plugging was commenced? yes

Name of Conservation Agent who supervised plugging of this well A. D. Fabricius  
Producing formation \_\_\_\_\_ Depth to top \_\_\_\_\_ Bottom \_\_\_\_\_ Total Depth of Well 4500 Feet  
Show depth and thickness of all water, oil and gas formations.

OIL, GAS OR WATER RECORDS

CASING RECORD

FORMATION	CONTENT	FROM	TO	SIZE	PUT IN	PULLED OUT
	Surface	0	284'	8 5/8"	282'	

Describe in detail the manner in which the well was plugged, indicating where the mud fluid was placed and the method or methods used in introducing it into the hole. If cement or other plugs were used, state the character of same and depth placed, from \_\_\_\_\_ feet to \_\_\_\_\_ feet for each plug set.

Plug set at 500' with 20 sacks cement  
Plug set at 275' with 20 sacks cement  
Plug set at 40' with 10 sacks cement

RECEIVED  
STATE CORPORATION COMMISSION  
DEC 10 1959  
DEC 10 1959  
CONSERVATION DIVISION  
Wichita, Kansas

(If additional description is necessary, use BACK of this sheet)

Name of Plugging Contractor Empire Drilling Company  
Address 650 Fourth National Bank Building, Wichita, Kansas

STATE OF KANSAS, COUNTY OF SEDGWICK, ss.  
Dan J. Kornfeld (Employee of Owner) or (owner or operator) of the above-described

well, being first duly sworn on oath, says: That I have knowledge of the facts, statements, and matters herein contained and the log of the above-described well as filed and that the same are true and correct. So help me God.

(Signature) Dan J. Kornfeld  
650-4th National Bank Building, Wichita, Ks.  
(Address)

SUBSCRIBED AND SWORN TO before me this 30th day of November, 19 59

My commission expires October 21, 1962

Lucille H. Harr  
Notary Public.



LOG

RECEIVED  
OPERATION COMMISSION  
DEC 10 1959  
DEC 10 1959  
CONSERVATION DIVISION  
Wichita, Kansas

COMPANY: Empire Drilling Company  
CONTRACTOR: Empire Drilling Company  
FARM: Selbe # 1  
LOCATION: SW SW SW of Section 6-7S-27W, Sheridan County, Kansas  
COMMENCED: November 17, 1959  
COMPLETED: November 28, 1959  
ELEVATION: 2729 KB  
POTENTIAL: D & A

\*\*\*\*\*

0	to	284	Surface
284	to	1025	Shale-Shells-Sand
1025	to	2456	Shale-Shells
2456	to	2491	Anhydrite
2491	to	2650	Shale-Shells
2650	to	2855	Shale-Lime
2855	to	3240	Shale-Shells
3240	to	3295	Shale-Lime
3295	to	3950	Lime-Shale
3950	to	4165	Lime
4165	to	4225	Lime-Shale
4225	to	4260	Shale-Lime
4260	to	4315	Shale
4315	to	4460	Shale-Lime
4460	to	4490	Mississippian
4490	to	4500	Mississippian Lime
4500			Rotary Total Depth

SET: 282' 8 5/8" with 125 sacks cement

ELECTRIC LOG TOPS:

Anhydrite	2453	+ 276
Heebner	3879	-1150
Toronto	3906	-1177
Lansing	3923	-1194
Base Kansas City	4130	-1401
Cherokee	4370	-1588
Mississippian	4448	-1719

\*\*\*\*\*

CERTIFICATION

I, Dan J. Kornfeld, do hereby certify that the above and foregoing is a true and correct copy of the log on the Selbe # 1, SW SW SW of Section 6-7S-27W, Sheridan County, Kansas, as reflected by the files of Empire Drilling Company.

*Dan J. Kornfeld*  
Dan J. Kornfeld

SUBSCRIBED AND SWORN to before me, a Notary Public within and for Sedgwick County, Kansas, this 30th day of November, 1959.

*Fidel H. Harr*  
Fidel H. Harr, Notary Public

My Commission expires October 21, 1962.