


STATE OF KANSAS
STATE CORPORATION COMMISSION

Form CP-4

WELL PLUGGING RECORD

Give All Information Completely
Make Required Affidavit
Mail or Deliver Report to:
Conservation Division
State Corporation Commission
212 No. Market
Wichita, Kansas

NORTH

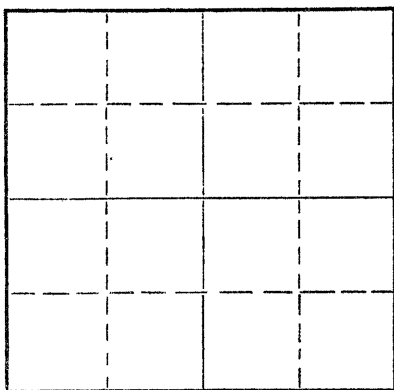

Locate well correctly on above
Section Plat

Sheridan County, Sec. 36 Twp. 7 Rge. 26 (E) W (W)
Location as "NE/CNW/SW" or footage from lines: Approximately NW NW NE
Lease Owner: Dreiling & Hiko Bell Mining & Oil Company
Lease Name: Sanger Well No. 1
Office Address: Route 2, Victoria, Kansas 67671
Character of Well (completed as Oil, Gas or Dry Hole): Dry Hole
Date well completed: 4-29 19 69
Application for plugging filed: 4-29 19 69
Application for plugging approved: 4-29 19 69
Plugging commenced: 4-29 19 69
Plugging completed: 4-29 19 69
Reason for abandonment of well or producing formation: Dry Hole

If a producing well is abandoned, date of last production: 19
Was permission obtained from the Conservation Division or its agents before plugging was commenced? Yes

Name of Conservation Agent who supervised plugging of this well: W. L. Nichols
Producing formation: Depth to top: Bottom: Total Depth of Well: Feet
Show depth and thickness of all water, oil and gas formations.

OIL, GAS OR WATER RECORDS

CASING RECORD

FORMATION	CONTENT	FROM	TO	SIZE	PUT IN	PULLED OUT
Surface Pipe				8 5/8"	252'	

Describe in detail the manner in which the well was plugged, indicating where the mud fluid was placed and the method or methods used in introducing it into the hole. If cement or other plugs were used, state the character of same and depth placed, from feet to feet for each plug set.

1st. plug was set @ 1325' with 100 sacks cement
2nd. plug was set @ 275' with 20 sacks cement
3rd. plug was set @ 40' with 10 sacks cement

STATE RECEIVED
MAY 5 1969
CONSERVATION DIVISION
Wichita, Kansas
MAY 5 1969

(If additional description is necessary, use BACK of this sheet)

Name of Plugging Contractor: L. J. Dreiling & Sons, Inc.
Address: Route 2, Victoria, Kansas 67671


STATE OF KANSAS, COUNTY OF ELLIS, ss.
I, Leo F. Dreiling (employee of owner) or (owner) of the above-described

well, being first duly sworn on oath, says: That I have knowledge of the facts, statements, and matters herein contained and the log of the above-described well as filed and that the same are true and correct. So help me God.

(Signature) Leo F. Dreiling

LEO F. DREILING, ROUTE 2, VICTORIA, KANSAS 67671
(Address)

Subscribed and sworn to before me this 1st day of May, 1969

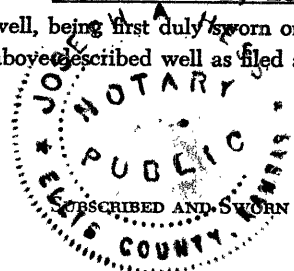

Joseph A. Hess
JOSEPH A. HESS Notary Public.

My commission expires September 19, 1970

