


STATE OF KANSAS  
STATE CORPORATION COMMISSION

WELL PLUGGING RECORD

Give All Information Completely  
Make Required Affidavit  
Mail or Deliver Report to  
Conservation Division  
State Corporation Comm.  
245 North Water  
Wichita, KS 67202

Sheridan County, Sec. 36 Twp. 7S Rge. 27 ~~W~~  
Location as "NE/CNW $\frac{1}{4}$ SW $\frac{1}{4}$ " or footage from lines  
1980' FNL & 1980' FWL SE NW

Lease Owner Lynco Oil Corporation  
Lease Name Cressler Well No. #1  
Colorado 80110  
Office Address 5290 DTC Parkway Building No. 2, Englewood,  
Character of Well (Completed as Oil, Gas or Dry Hole)  
Dry Hole

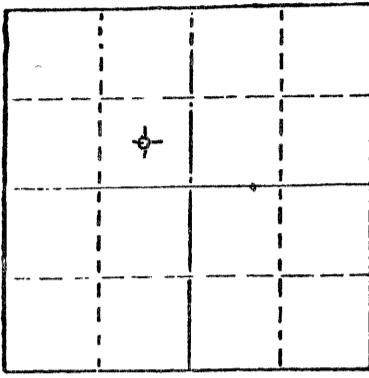

Locate well correctly on above  
Section Plat

Date Well completed 1-7-79 19  
Application for plugging filed 1-7-79 19  
Application for plugging approved 1-7-79 19  
Plugging commenced 1-7-79 19  
Plugging completed 1-7-79 19

Reason for abandonment of well or producing formation  
Commercial quantities of oil not found  
If a producing well is abandoned, date of last production 19

Was permission obtained from the Conservation Division or  
its agents before plugging was commenced? Yes

Name of Conservation Agent who supervised plugging of this well Gilbert Balthazor, Palco, Ks.  
Producing formation None Depth to top Bottom Total Depth of Well 4100'  
Show depth and thickness of all water, oil and gas formations.

OIL, GAS OR WATER RECORDS

CASING RECORD

FORMATION	CONTENT	FROM	TO	SIZE	PUT IN	PULLED OUT
				8 5/8"	320'	None

Describe in detail the manner in which the well was plugged, indicating where the mud fluid  
was placed and the method or methods used in introducing it into the hold. If cement or other  
plugs were used, state the character of same and depth placed, from \_\_\_\_\_ feet to  
\_\_\_\_\_ feet for each plug set.

- Plug @ 1250' w/70 sx.
- Plug @ 300' w/20 sx.
- Plug @ 40' w/10 sx.
- Rat Hole 5 sx.

(If additional description is necessary, use BACK of this sheet)

Name of Plugging Contractor Rains & Williamson Oil Co., Inc.

RECEIVED  
STATE CORPORATION COMMISSION  
FEB 25 1979  
FEB 23 1979  
CONSERVATION DIVISION  
Wichita, Kansas


STATE OF Kansas COUNTY OF Sedgwick  
Wilson Rains, President of Rains & Williamson (employee of owner) or (owner or operator)  
of the above-described well, being first duly sworn on oath, says: That I have knowledge of  
the facts, statements, and matters herein contained and the log of the above-described well  
as filed and that the same are true and correct. So help me God.

(Signature) Wilson Rains  
435 Page Court, 220 W. Douglas, Wichita, Ks. 67202  
(Address)

SUBSCRIBED AND SWORN TO before me this 12 day of January, 1979

My commission expires 10-4-79

Juanita M. Green  
Juanita M. Green Notary Public.

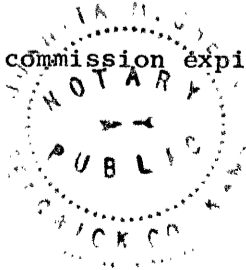

DRILLER'S LOG

COMPANY: Lynco Oil Corporation

SEC. 36 T. 7S R. 27W

WELL NAME: Cressler #1

LOC. 1980' FNL & 1980' FWL  
SE NW

COUNTY: Sheridan

RIG NO. #1

TOTAL DEPTH 4100'

ELEVATION 2672 GR

COMMENCED: 12-31-78

COMPLETED: 1-7-79

CONTRACTOR: Rains & Williamson Oil Co., Inc.

CASING RECORD:

SURFACE: 8 5/8" @ 320' w/220 sx. 40/60 poz., 2% gel, 3% cc.

PRODUCTION: D&A

LOG

(Figures Indicate Bottom of Formations)

Shale & Sand	2500
Shale	2882
Shale & Sand	3130
Shale, Sand & Lime	3360
Shale	3668
Shale, Lime & Sand	3868
Lime & Shale	4100
<u>ROTARY TOTAL DEPTH</u>	<u>4100</u>

STATE OF Kansas )

COUNTY OF Sedgwick )

SS:

I, Wilson Rains, President of Rains & Williamson Oil Co., Inc.

upon oath state that the above and foregoing is a true and correct copy of the log of the Cressler #1 well.

Wilson Rains  
Wilson Rains

RECEIVED  
STATE CORPORATION COMMISSION  
FEB 23 1979  
Feb 23, 1979  
CONSERVATION DIVISION  
Wichita, Kansas



Subscribed and sworn to before me this 12 day of January, 1979.

My Appointment Expires:  
10-4-79

Juanita M. Green  
Juanita M. Green